

City of Prince George
HISTORY SHEET

SHEET NUMBER

Roll Number 011881518

Legal: LOT'S 30 BLOCK D.L. 2507 PLAN 16227

Address: 821 OSPIKA BLVD.

Sanitary Connection: # 5190 SIZE 100 mm MATERIAL A.C. INV. CONNECTED

Water Connection # 5190 SIZE 20 mm MATERIAL CU METER CONNECTED

Storm Connection: # SIZE MATERIAL INV. CONNECTED

Cash Receipt No's: WATER SANITARY STORM

CURB FROM PROPERTY LINE 4.877 m PAVEMENT WIDTH 10.363 m

B.C. HYDRO U/G UNDERGROUND CONNECTION


B.C. TELEPHONE U/G UNDERGROUND CONNECTION

INLAND GAS AS SHOWN


Information Sheets:

Comments:

THE INFORMATION CONTAINED HEREIN IS FOR INTERNAL USE ONLY.
NOT TO BE RELIED UPON UNLESS CONFIRMED BY SITE INSPECTION AND/OR INVESTIGATION

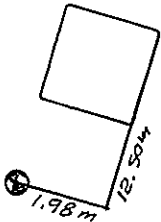

RAINBOW DR.

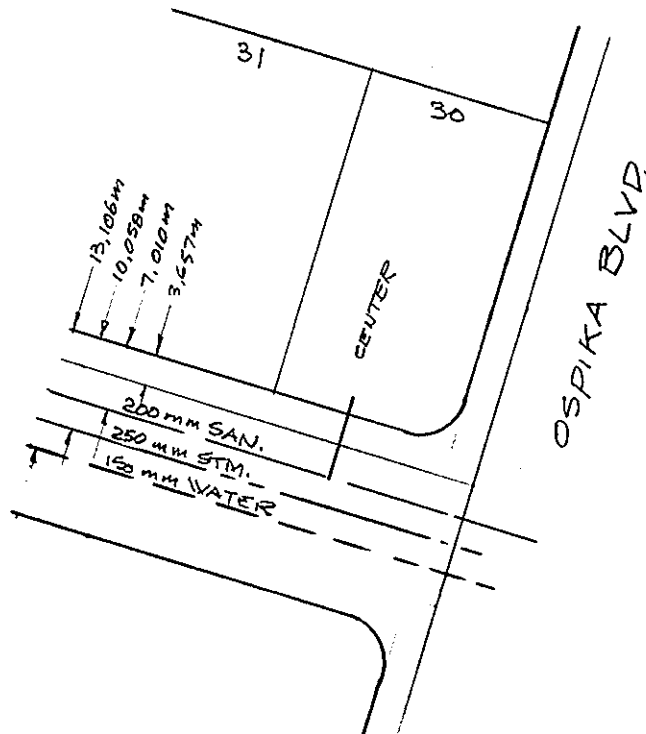


REPORT TO RECORDS

WATER SERVICE INFORMATION 04881578

Lot No. 30 Block 2507 P.L. 16227Address 821 Ospika BlvdSize of Connection ☐ 1/2" ☐ 3/4" ☐ Other _____Type of Connection ☐ Copper ☐ IronThaw Wire ☐ Yes ☐ No

LOCATION SKETCH

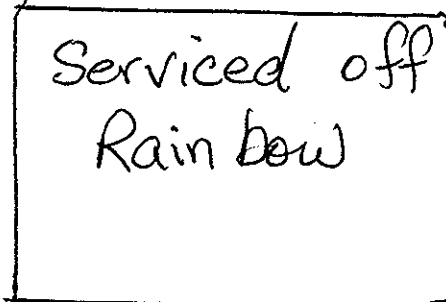North
↑12.05
↓
2.0m

Field Location By

W Bond

Date

Oct 2/90

Checked by: _____