



City of Prince George
History Sheet

PID:	011890223
MU:	101380
WO:	71400/71401

Civic Address: 1653 Juniper St

Legal Description: Lot: 5 Block: 259 District Lot: 343 Plan: 1268


Service Type	Diameter (mm)	Material	Invert Elev at main (m)	Invert Elev at property line (m)	Invert Elev at service end (m)	Distance into property (m)	Installation Date
Sanitary	100mm	PVC	-	-	-	-	May 2013
Water	20mm	Copper	-	-	-	-	May 2013
Storm	N/A	N/A	-	-	-	-	

Service Connection Location				Sanitary (m)	Storm (m)
Distance from downstream San MH	3198	towards upstream San MH	3993	70.00	
Distance from downstream Stm MH	-	towards upstream Stm MH	-		

Power	Size	Communications	Size	Cable	Size	Gas	Size
BC Hydro	-	Telus	-	Shaw	-	FortisBC	-
Overhead Service		Overhead Service		Overhead Service			

Installed by:	City of Prince George forces	Survey Date:	-
Comments:			

NOT TO SCALE The information contained herein is for internal use only.
Not to be relied on unless confirmed by site inspection and/or investigation.

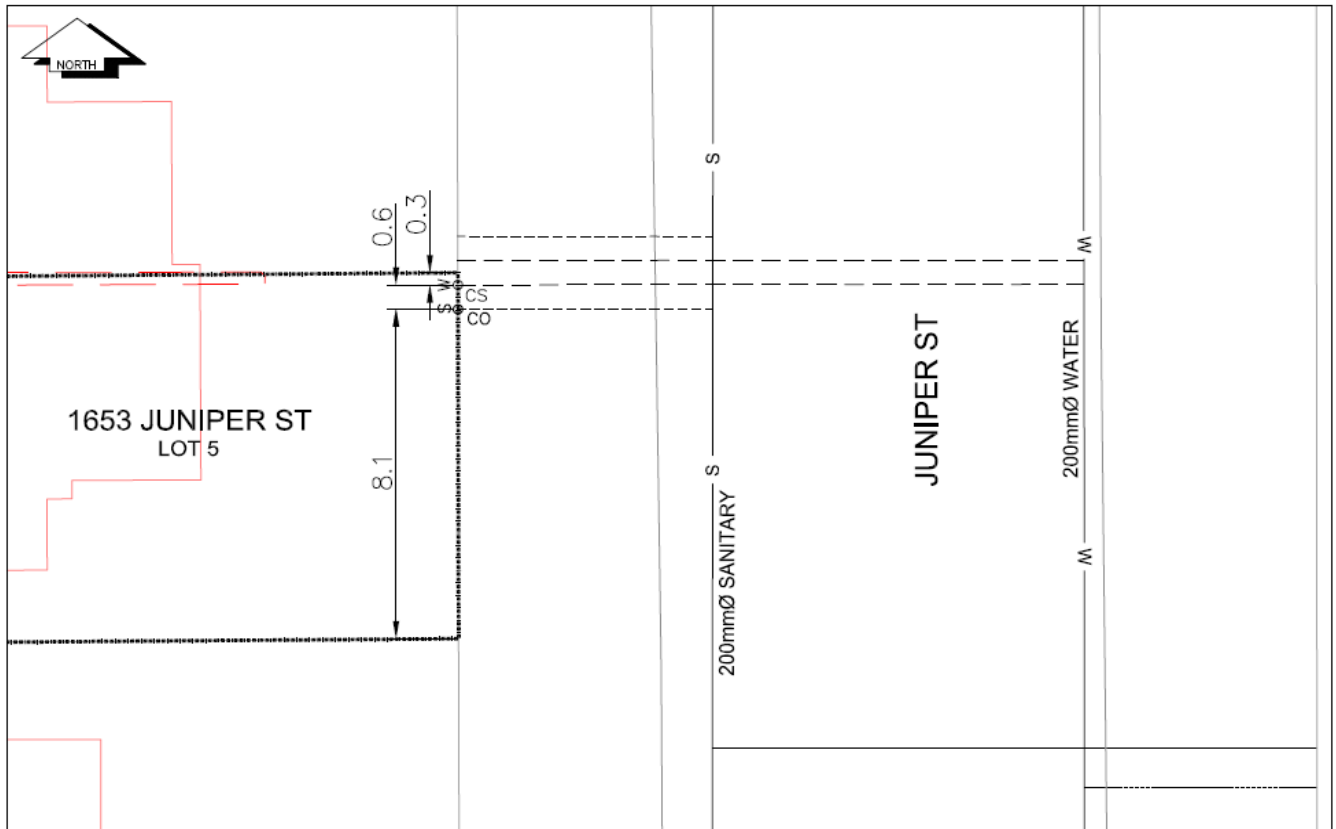

LEGEND:	CS ^o	CURB STOP	---	W	WATER SERVICE	---	---	W	STORM SERVICE
	CO ^o	CLEAN OUT	---	S	SANITARY SERVICE	---	---	W	WATER VALVE

NOT TO SCALE