

City of Prince George
HISTORY SHEET

SHEET NUMBER

Roll Number 011897228

Legal: LOT'S 33 BLOCK D.L. 753 PLAN 16011

Address: 5240 YORK DR

Sanitary Connection: # SIZE MATERIAL INV. CONNECTED

Water Connection # SIZE 20mm MATERIAL CU METER CONNECTED

Storm Connection: # SIZE MATERIAL INV. CONNECTED

Cash Receipt No's: WATER SANITARY STORM

CURB FROM PROPERTY LINE PAVEMENT WIDTH


B.C. HYDRO UNDERGROUND CONNECTION

B.C. TELEPHONE UNDERGROUND CONNECTION

INLAND GAS

Information Sheets:

Comments:

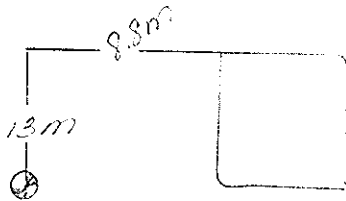

SITE

PLAN

N.T.S.

