



City of Prince George
History Sheet

PID:	011940808
SD/MU:	
WO:	

Civic Address: 5515 Park Dr

Legal Description: Lot: 119 District Lot: 1599 Plan: 15792


Service Type	Diameter (mm)	Material	Invert Elev at main (m)	Invert Elev at property line (m)	Invert Elev at service end (m)	Distance into property (m)	Installation Date
Sanitary	100mm	PVC	-	-	-	-	-
Water	20mm	Copper	-	-	-	-	-
Storm	N/A	N/A	-	-	-	-	-

Service Connection Location			Sanitary (m)	Storm (m)
Distance from downstream San MH	-	towards upstream San MH	-	-
Distance from downstream Stm MH	-	towards upstream Stm MH	-	-

Power	Size	Communications	Size	Cable	Size	Gas	Size
BC Hydro	-	Telus	-	Shaw	-	FortisBC	-
Overhead Service		Overhead Service		Overhead Service			

Installed by:	City of Prince George forces	Survey Date:	-
Comments:	Standpipe is on neighbor's property		

NOT TO SCALE The information contained herein is for internal use only.
Not to be relied on unless confirmed by site inspection and/or investigation.

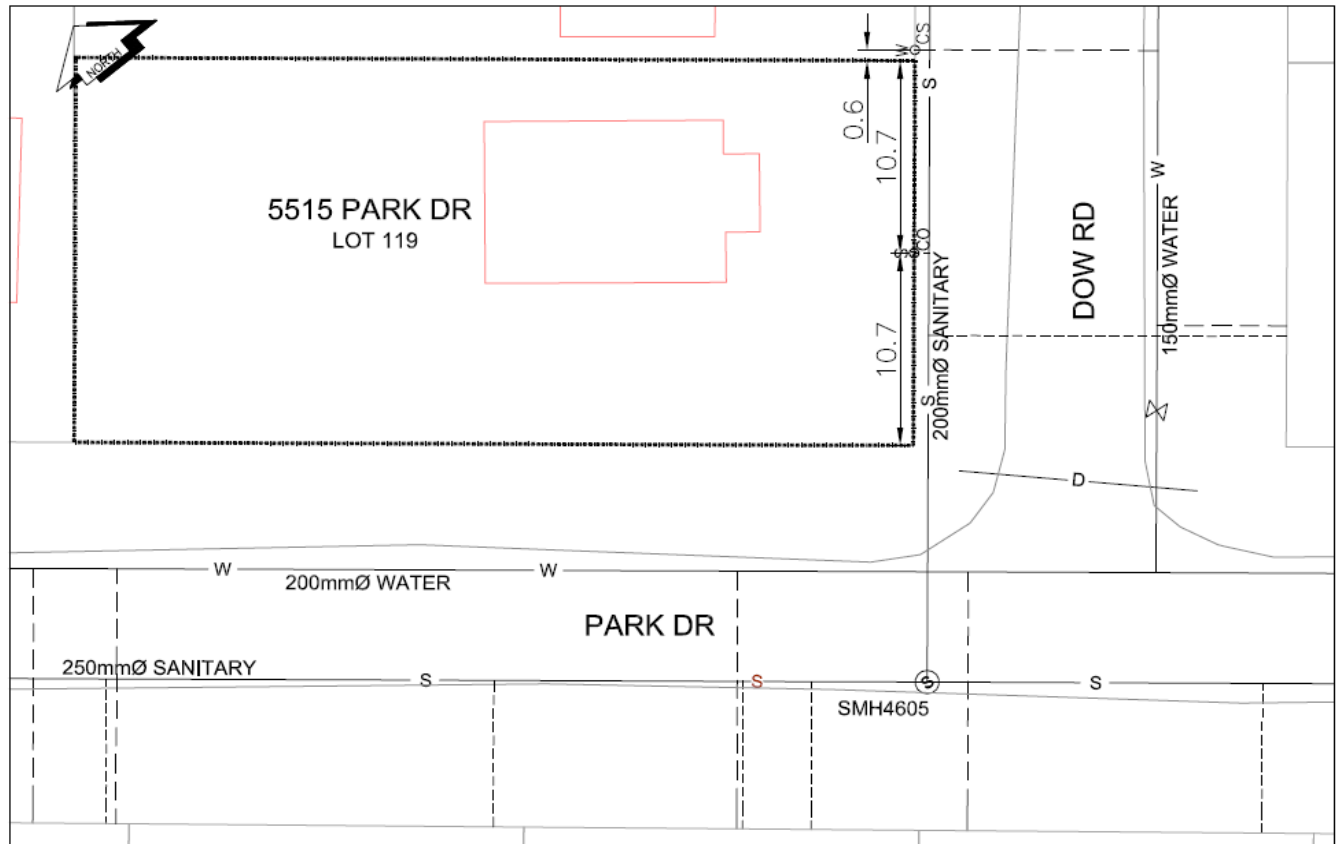

LEGEND:	CS ^o	CURB STOP	— — — — —	WATER SERVICE	— — — — —	STORM SERVICE
	CO ^o	CLEAN OUT	— — — — —	SANITARY SERVICE	— — — — —	WATER VALVE

NOT TO SCALE