



# City of Prince George History Sheet

PID:	011959762
SD/MU:	
WO:	

Civic Address: 7737 Dow Rd

Legal Description: Lot: 115 District Lot: 1599 Plan: 15792


Service Type	Diameter (mm)	Material	Invert Elev at main (m)	Invert Elev at property line (m)	Invert Depth at service end (m)	Distance into property (m)	Installation Date
Sanitary	100mm	AC	-	-	3.72	-	December 1965
Water	20mm	Copper	-	-	-	-	December 1983
Storm	N/A	N/A	-	-	-	-	

Service Connection Location				Sanitary (m)	Storm (m)
Distance from downstream San MH	4605	towards upstream San MH	4566	110.47	
Distance from downstream Stm MH	-	towards upstream Stm MH	-		

Power	Size	Communications	Size	Cable	Size	Gas	Size
BC Hydro	-	Telus	-	Shaw	-	FortisBC	-
Overhead Service		Overhead Service		Overhead Service			

Installed by:		Survey Date:	-
Comments:	Water service confirmed on May 2019.		

**NOT TO SCALE** The information contained herein is for internal use only.  
Not to be relied on unless confirmed by site inspection and/or investigation.

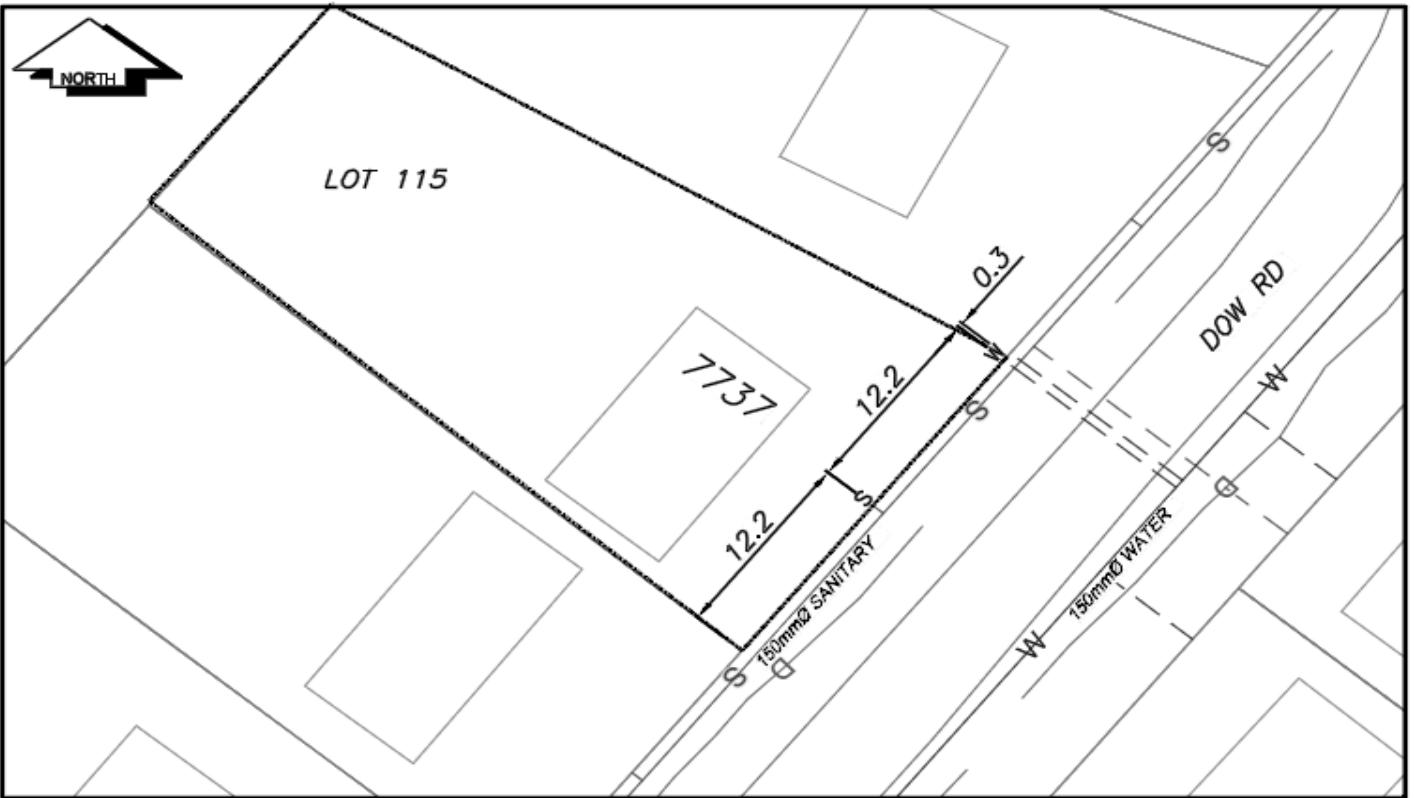

CS <sup>o</sup> CURB STOP	---W--- WATER SERVICE	---S--- STORM SERVICE
CO <sup>o</sup> CLEAN OUT	---S--- SANITARY SERVICE	---G--- GAS
WATER VALVE	---FH--- FIRE HYDRANT	---E--- ENCUMBRANCE

**NOT TO SCALE**