



CITY OF
PRINCE GEORGE

City of Prince George HISTORY SHEET

PID:	011-976-063
SD/MU:	
WO:	

CIVIC ADDRESS: 1073 CENTRAL STREET W.

LEGAL DESCRIPTION: LOT 8 DISTRICT LOT 936 PLAN 15557

SERVICE TYPE	DIAMETER (mm)	MATERIAL	INVERT ELEV AT MAIN (m)	INVERT ELEV AT PROPERTY LINE (m)	INVERT ELEV AT SERVICE END (m)	COVER AT PROPERTY LINE (m)	DISTANCE INTO PROPERTY (m)	INSTALLATION DATE
SANITARY	100	PVC	591.15	596.37	AT BUILDING	2.93	AT BUILDING	UNKNOWN
WATER	50	COPPER	-	596.79	AT BUILDING	2.56	AT BUILDING	JUNE 2022
STORM	N/A	N/A	N/A	N/A	N/A	N/A	N/A	N/A

ELECTRICAL / COMMUNICATIONS / GAS

TYPE	PROVIDER	SIZE AND MATERIAL	LOCATION (UNDERGROUND/ OVERHEAD)
ELECTRICAL	BC HYDRO	100mm	UNDERGROUND
COMMUNICATION	TELUS	UNKNOWN	UNDERGROUND
COMMUNICATION	SHAW	UNKNOWN	UNDERGROUND
GAS	FORTISBC	UNKNOWN	UNDERGROUND


INFORMATION SHEETS: L&M ENGINEERING LIMITED PROJECT NUMBER 1711-05

SURVEY DATE: -

INSTALLED BY: DATOFF BROS CONSTRUCTION LTD.

COMMENTS: SANITARY SERVICE ELEVATIONS ARE FROM THE PREVIOUS LOT HISTORY SHEET AND WERE NOT SURVEYED BY L&M ENGINEERING. TELUS, SHAW, AND FORTIS SERVICES WERE INSTALLED PREVIOUSLY AND LOCATION ARE APPROXIMATE.

THE INFORMATION CONTAINED HEREIN IS FOR INTERNAL USE ONLY.
NOT TO BE RELIED UPON UNLESS CONFIRMED BY SITE INVESTIGATION.

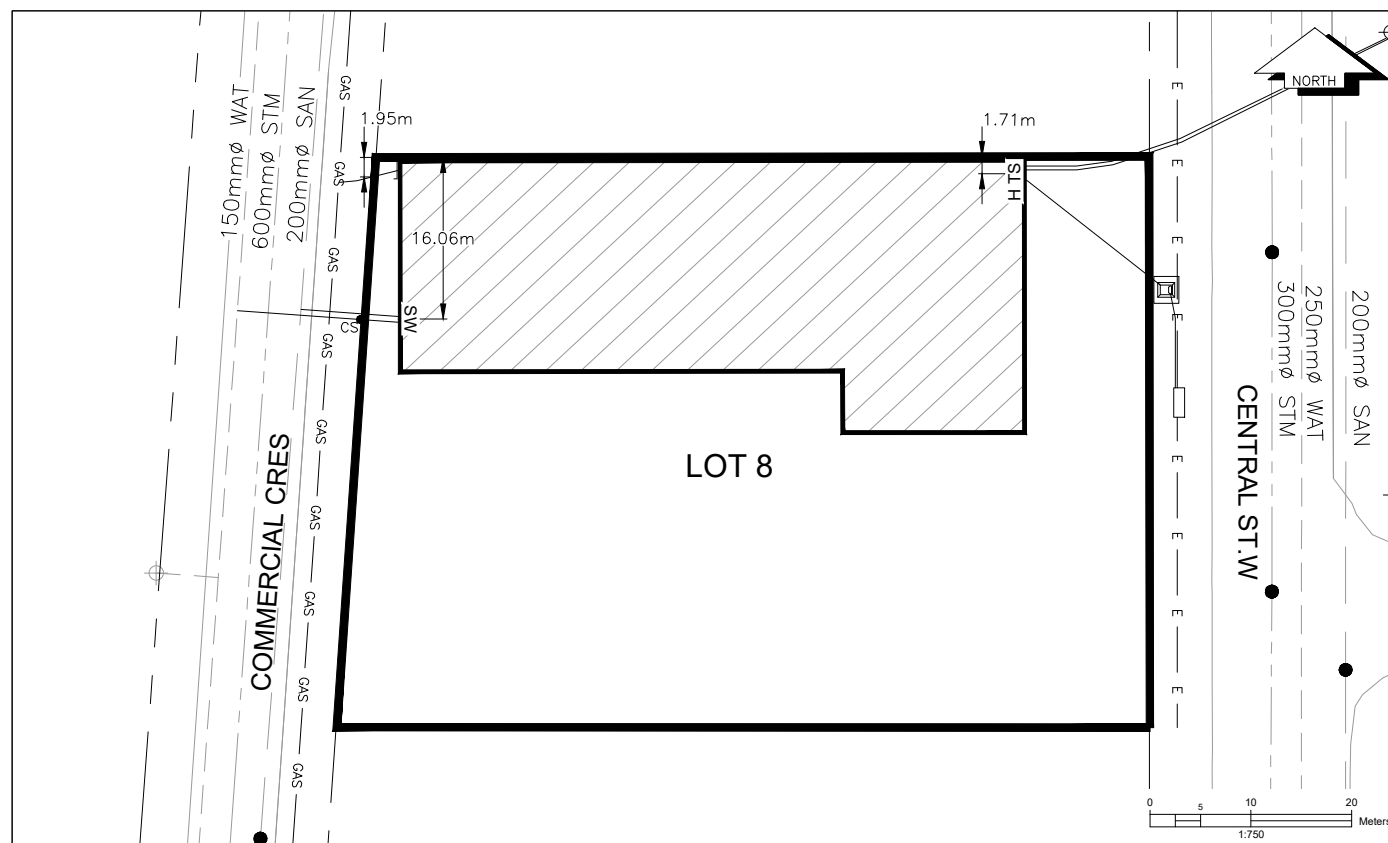

LEGEND:

CS CURB STOP
CO CLEAN OUT

W WATER SERVICE
S D W STORM SERVICE
S SANITARY SERVICE

H HYDRO SERVICE
T TELECOMMUNICATIONS

GAS GAS
UG SHALLOW UTILITIES