



City of Prince George  
**History Sheet**

PID:	012029530
SD/MU:	
WO:	

Civic Address: 211 233 255 277 299 Ospika Blvd  
238 252 266 280 294 McIntyre Cress  
4028 McCae Ave


Legal Description: Block: C District Lot: 1427 Plan: 15150

Service Type	Diameter (mm)	Material	Invert Elev at main (m)	Invert Elev at property line (m)	Invert Elev at service end (m)	Distance into property (m)	Installation Date
Sanitary (S1)	100mm	AC	-	-	-	-	December 1965
Sanitary (S2)	100mm	AC	-	-	-	-	December 1965
Sanitary (S3)	100mm	AC	-	-	-	-	December 1965
Sanitary (S4)	100mm	AC	-	-	-	-	December 1965
Sanitary (S5)	100mm	AC	-	-	-	-	December 1965
Water	100mm	Galv, Steel	-	-	-	-	December 1961
Storm	150mm	AC	-	-	-	-	December 1965
Storm	150mm	AC	-	-	-	-	December 1965
Power	Size	Communications	Size	Cable	Size	Gas	Size
BC Hydro	-	Telus	-	Shaw	-	FortisBC	-
Overhead Service		Overhead Service		Overhead Service			

Installed by:	Survey Date:	-
Comments: Sanitary services exact location to be verified as dye testing was used to determine the general location - March 2017		

**NOT TO SCALE** The information contained herein is for internal use only.  
Not to be relied on unless confirmed by site inspection and/or investigation.

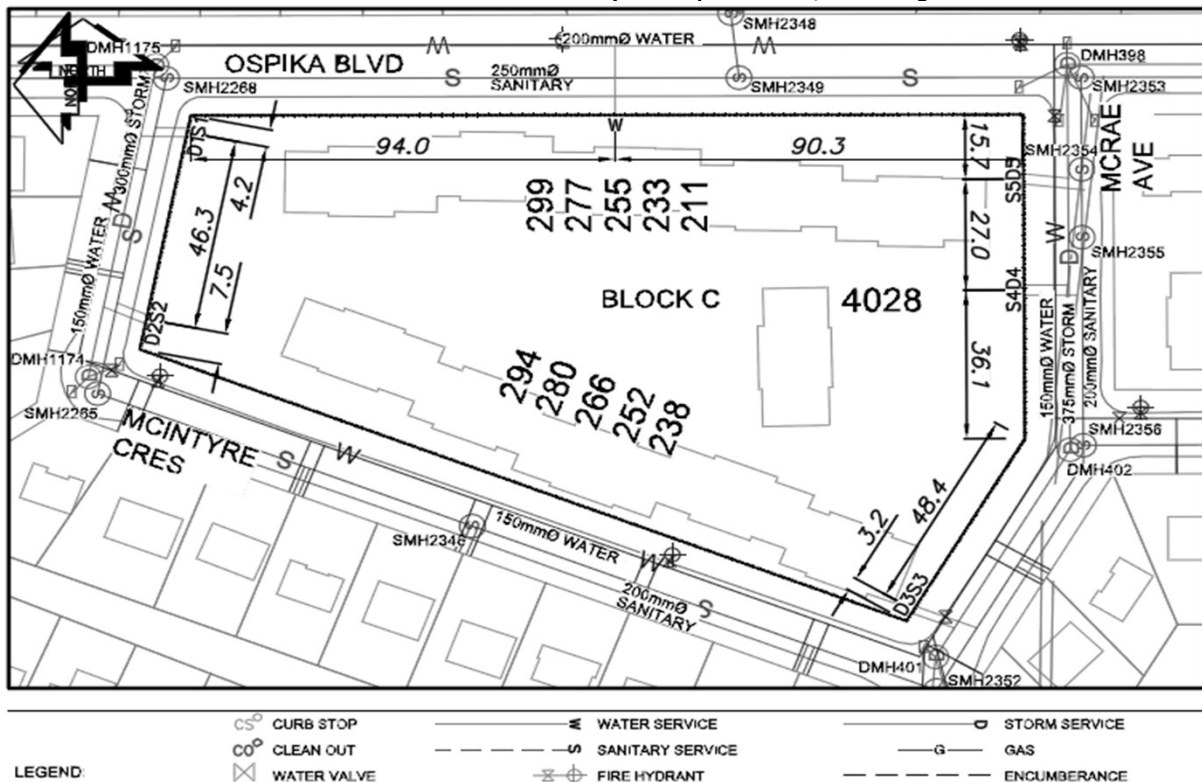

**NOT TO SCALE**