

City of Prince George  
HISTORY SHEET

012051161

SHEET NUMBER

PID #

Legal: LOT'S 317 BLOCK D.L. 936 PLAN 15185

Address: 1152 BABINE CRES.

Sanitary Connection: # 4836 SIZE 100 mm MATERIAL A.C. INV. CONNECTED

Water Connection: # 4836 SIZE 20 mm MATERIAL C.U. METER CONNECTED

Storm Connection: # SIZE mm MATERIAL INV. CONNECTED

Cash Receipt No's: WATER PAID IN LOT PRICE SANITARY PAID IN LOT PRICE STORM

CURB FROM PROPERTY LINE 4.877 m PAVEMENT WIDTH 10.363 m

B.C. HYDRO U/G UNDERGROUND CONNECTION


B.C. TELEPHONE U/G UNDERGROUND CONNECTION

INLAND GAS AS SHOWN

Information Sheets:

Comments:

THE INFORMATION CONTAINED HEREIN IS FOR INTERNAL USE ONLY.  
NOT TO BE RELIED UPON UNLESS CONFIRMED BY SITE INSPECTION AND/OR INVESTIGATION

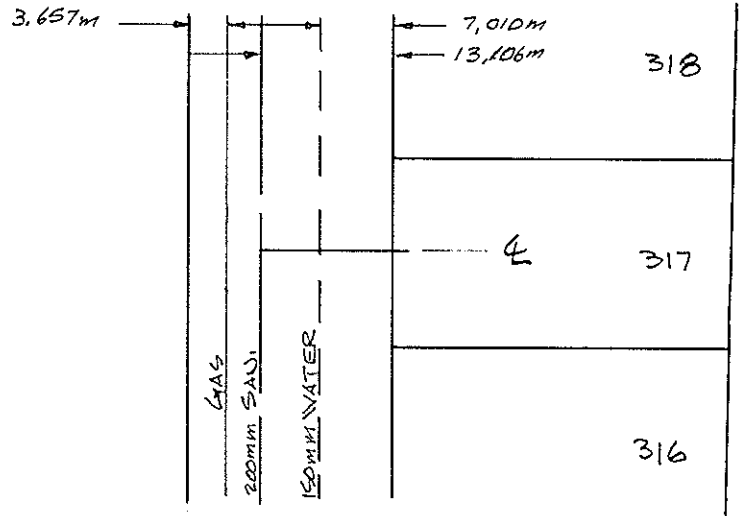

BABINE CRES.

