

City of Prince George
HISTORY SHEET

012052515

SHEET NUMBER

PID #

Legal: LOTS 318 BLOCK D.L. 936 PLAN 15185

Address: 1142 BABINE CRES.

Sanitary Connection: # 4837 SIZE 100 mm MATERIAL A.C. INV. CONNECTED

Water Connection: # 4837 SIZE 20 mm MATERIAL C.U. METER CONNECTED

Storm Connection: # SIZE mm MATERIAL INV. CONNECTED

Cash Receipt No's: WATER PAID IN LOT PRICE SANITARY PAID IN LOT PRICE STORM

CURB FROM PROPERTY LINE 4.877m PAVEMENT WIDTH 10.363m

B.C. HYDRO U/G UNDERGROUND CONNECTION



B.C. TELEPHONE U/G UNDERGROUND CONNECTION

INLAND GAS AS SHOWN

Information Sheets:

Comments:

THE INFORMATION CONTAINED HEREIN IS FOR INTERNAL USE ONLY.
NOT TO BE RELIED UPON UNLESS CONFIRMED BY SITE INSPECTION AND/OR INVESTIGATION

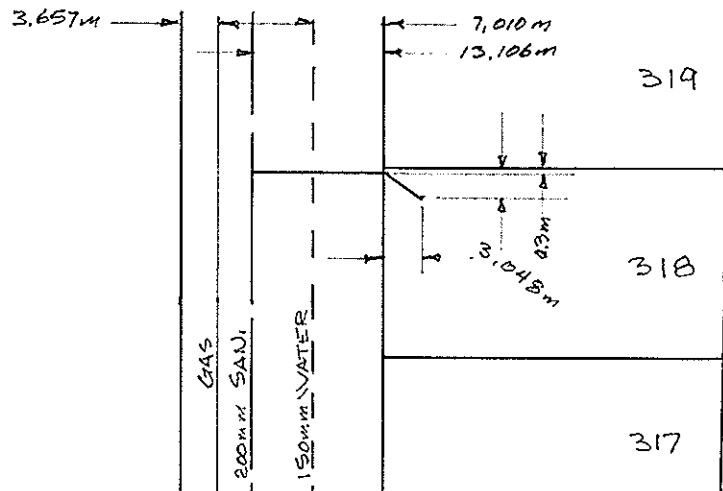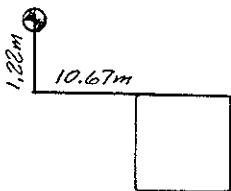

BABINE CRES

