

0Y2052604

PID #

Address: 1112 BABINE CRES.

Water Connection: # 4839 SIZE 20 mm MATERIAL CU, METER CONNECTED

Storm Connection:	#	SIZE	mm	MATERIAL	INV.	CONNECTED
-------------------	---	------	----	----------	------	-----------

Cash Receipt No's: WATER PAID IN LOT PRICE SANITARY PAID IN LOT PRICE STORM

CURB FROM PROPERTY LINE 4.877 m PAVEMENT WIDTH 10.363 m

B.C. HYDRO 0/G UNDERGROUND CONNECTION



B.C. TELEPHONE 0/6 UNDERGROUND CONNECTION

INLAND GAS AS SHOWN

Information Sheets:

Comments:

**THE INFORMATION CONTAINED HEREIN IS FOR INTERNAL USE ONLY.
NOT TO BE RELIED UPON UNLESS CONFIRMED BY SITE INSPECTION AND/OR INVESTIGATION**

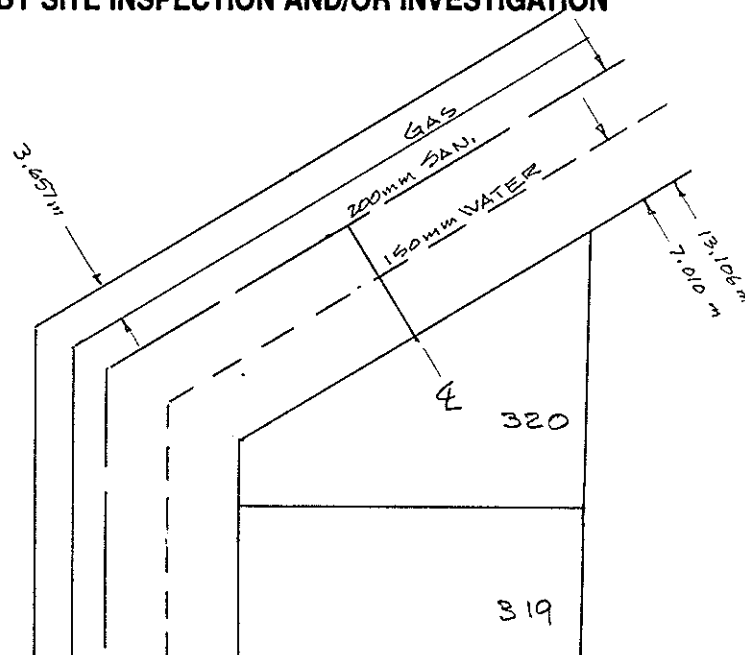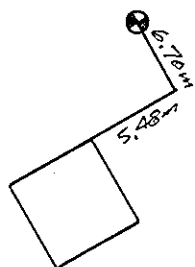

WABIN/LEVIN

