



City of Prince George History Sheet

PID:	012085766
MU:	102087
WO:	99417/99418

Civic Address: 2108, 2130, 2140 Quinn St

Legal Description: Lot: PCL A (F3961) District Lot: 936 Plan: 15083


Service Type	Diameter (mm)	Material	Invert Elev at main (m)	Invert Elev at property line (m)	Invert Depth at service end (m)	Distance into property (m)	Installation Date
Sanitary (S1)	100mm	AC	-	-	2.38	-	December 1964
Water (W1)	25mm	Copper	-	-	-	-	December 1964
Water (W2)	25mm	Copper	-	-	-	-	December 1964
Sanitary (S2)	100mm	PVC	600.91	606.37	-	-	May 2019
Water (W3)	25mm	Copper	601.29	601.24	-	-	May 2019
Storm	300mm	Vit	-	-	-	-	December 1966

Service Connection Location					Sanitary (m)	Storm (m)
Distance from downstream San MH	-	towards upstream San MH	-	-	-	
Distance from downstream Stm MH	-	towards upstream Stm MH	-	-	-	

Power	Size	Communications	Size	Cable	Size	Gas	Size
BC Hydro	-	Telus	-	Shaw	-	FortisBC	-
Overhead Service		Overhead Service		Overhead Service			

Installed by:	City of Prince George forces	Survey Date:	-
Comments:			

NOT TO SCALE The information contained herein is for internal use only.
Not to be relied on unless confirmed by site inspection and/or investigation.

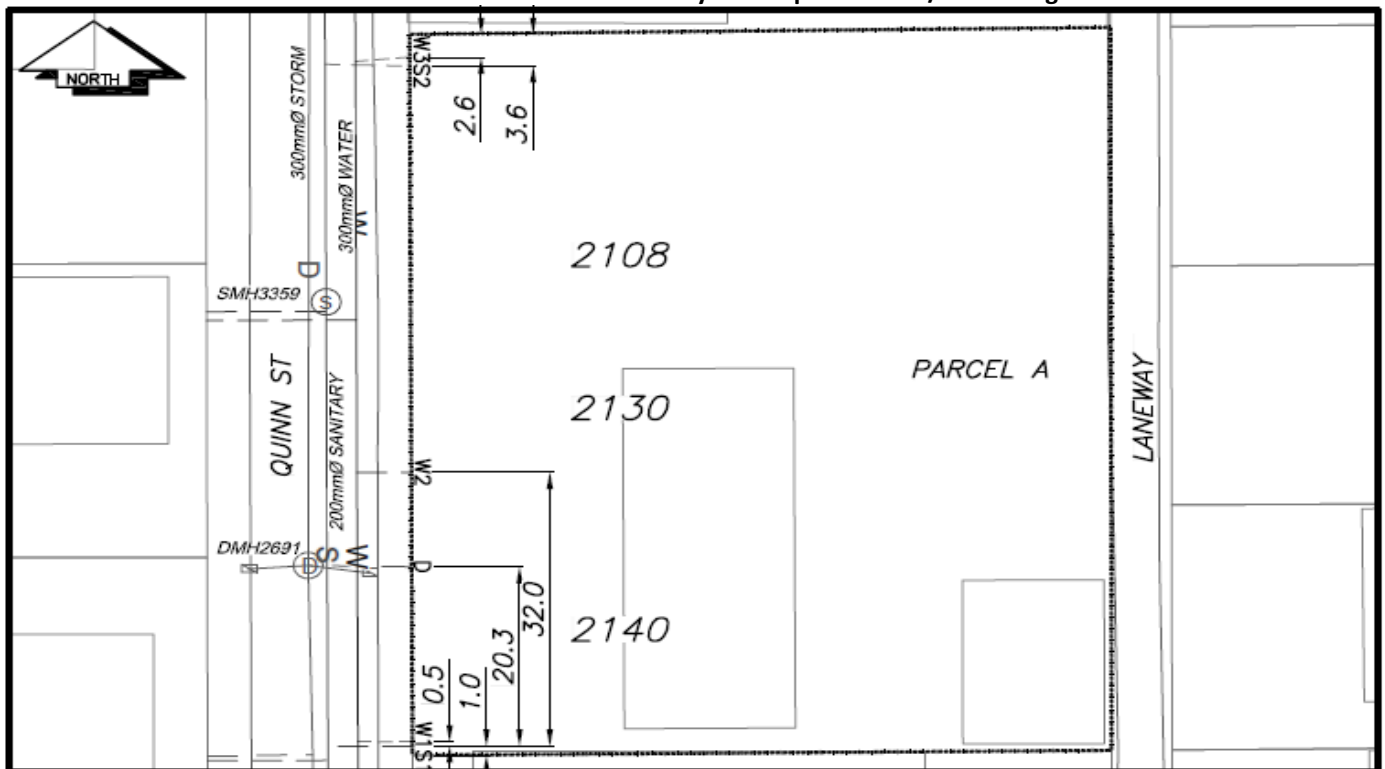

CS ^o CURB STOP	—W— WATER SERVICE	—S— STORM SERVICE
CO ^o CLEAN OUT	- - - - - SANITARY SERVICE	—G— GAS
⊗ WATER VALVE	⊗ FIRE HYDRANT	- - - - - ENCUMBERANCE

NOT TO SCALE