


### Lot Servicing

501 RADCLIFFE DR  
Lot: 37, Plan: 15089, DL: 1427

PID: 012086703

SERVICE	SIZE	MATERIAL	INSTALLED DATE	LOCATION	DETAILS
WATER	20MM	CU		FR SE COR BLD 7.5M S 14.0M E	CONNECTION NUMBER 5060
WATER	50MM	CU		5.5M N OF S PL	CASH RECEIPT NUMBER MU100702
SANITARY	UNKNOWN	UNKNOWN		0.6M N OF SE COR PL	CONNECTION # 5060

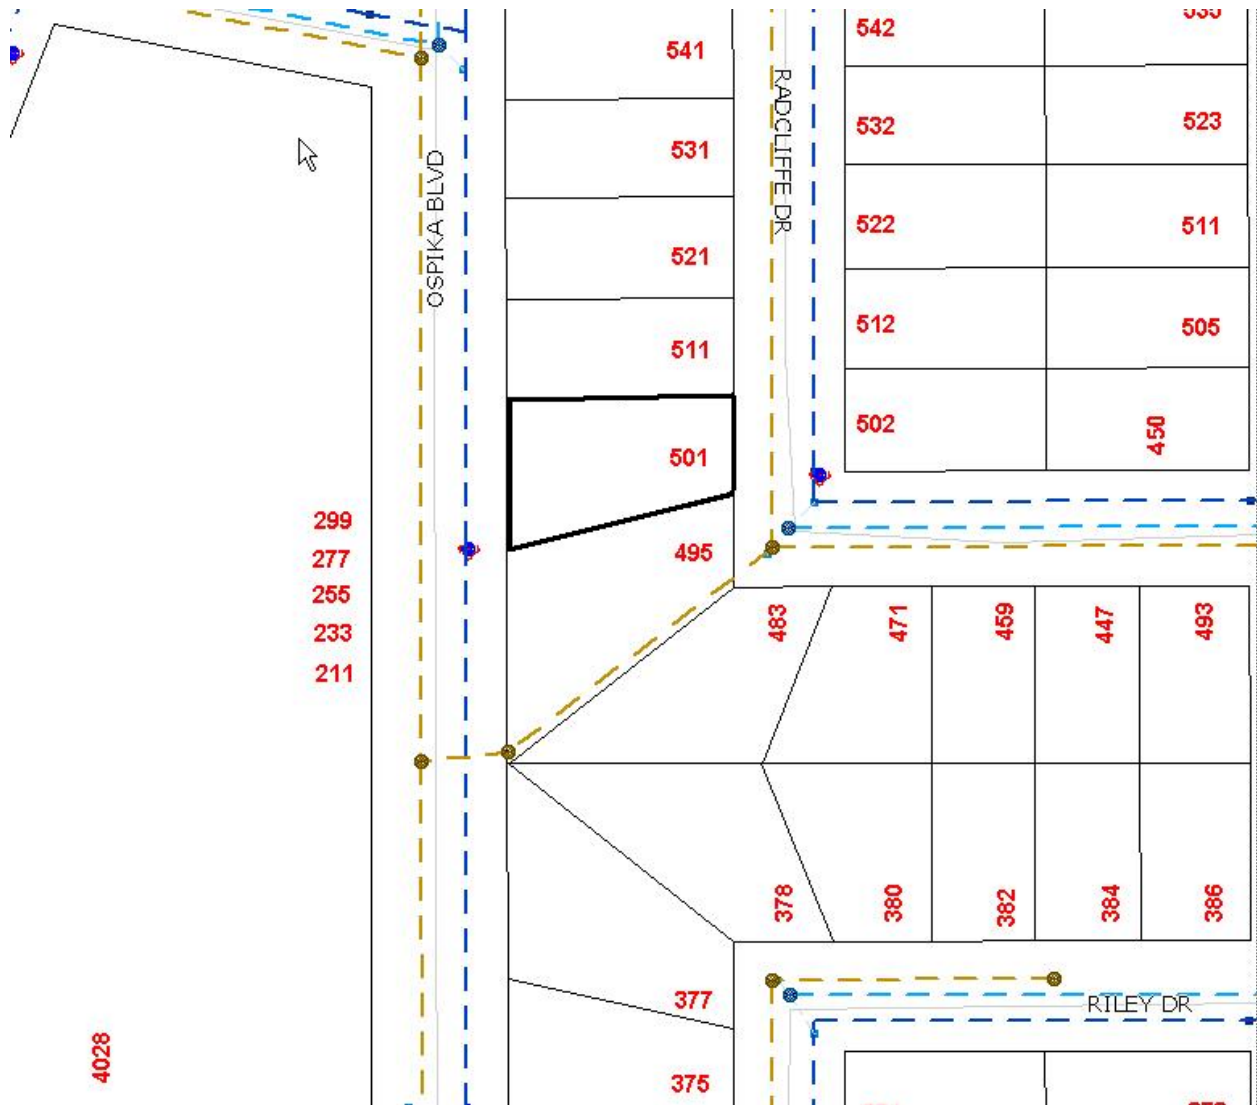

Accuracy not guaranteed unless confirmed by site inspection and/or investigation.  
Connection location between main and property line only.