



City of Prince George History Sheet

PID:	012132322
MU:	100950
WO:	47769

Civic Address: 3910 Lansdowne Rd

Legal Description: Lot: 2 District Lot: 925 Plan: 14821


Service Type	Diameter (mm)	Material	Invert Elev at main (m)	Invert Elev at property line (m)	Invert Elev at service end (m)	Distance into property (m)	Installation Date
Sanitary	N/A	N/A	-	-	-	-	July 2009
Water	50mm	Copper	-	-	-	-	July 2009
Storm	N/A	N/A	-	-	-	-	

Service Connection Location						Sanitary (m)	Storm (m)
Distance from downstream San MH			-	towards upstream San MH	-	-	
Distance from downstream Stm MH			-	towards upstream Stm MH	-		

Power	Size	Communications	Size	Cable	Size	Gas	Size
BC Hydro	-	Telus	-	Shaw	-	FortisBC	-
Overhead Service		Overhead Service		Overhead Service			

Installed by:	City of Prince George forces	Survey Date:	-
Comments:			

NOT TO SCALE The information contained herein is for internal use only.
Not to be relied on unless confirmed by site inspection and/or investigation.

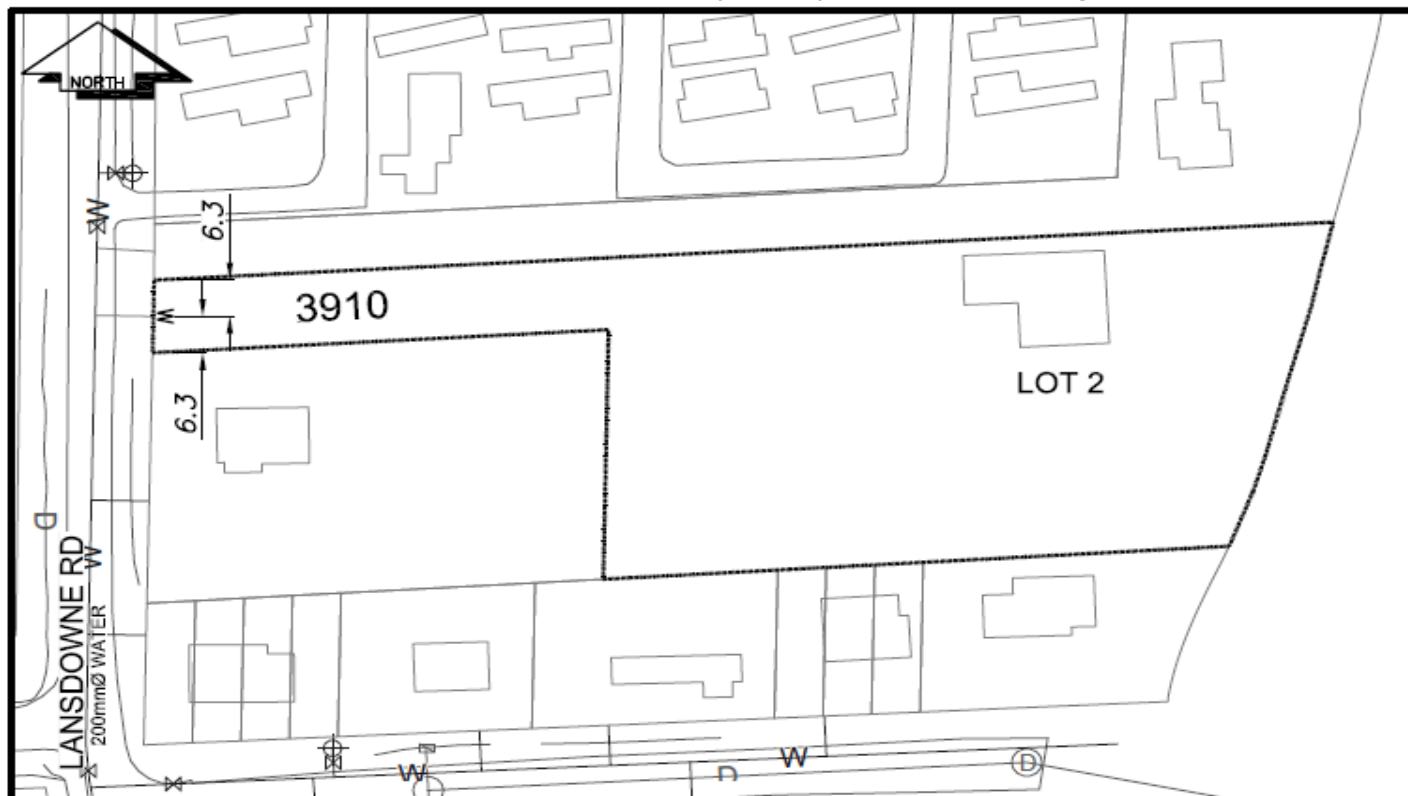

CS ^o CURB STOP	W WATER SERVICE	D STORM SERVICE
CO ^o CLEAN OUT	S SANITARY SERVICE	G GAS
X WATER VALVE	H FIRE HYDRANT	ENCUMBERANCE

NOT TO SCALE