

**City of Prince George  
HISTORY SHEET**

012134023

SHEET NUMBER \_\_\_\_\_ Roll Number \_\_\_\_\_

Legal: LOT'S 18 BLOCK \_\_\_\_\_ D.L. 10226 PLAN 14830

Address: A861 CREST RD.

Sanitary Connection: # \_\_\_\_\_ SIZE \_\_\_\_\_ MATERIAL \_\_\_\_\_ INV. \_\_\_\_\_ CONNECTED \_\_\_\_\_

Water Connection # \_\_\_\_\_ SIZE 20mm MATERIAL CU. METER \_\_\_\_\_ CONNECTED \_\_\_\_\_

Storm Connection: # \_\_\_\_\_ SIZE \_\_\_\_\_ MATERIAL \_\_\_\_\_ INV. \_\_\_\_\_ CONNECTED \_\_\_\_\_

Cash Receipt No's: WATER \_\_\_\_\_ SANITARY \_\_\_\_\_ STORM \_\_\_\_\_

CURB FROM PROPERTY LINE \_\_\_\_\_ PAVEMENT WIDTH 10.000 m

B.C. HYDRO O/H UNDERGROUND CONNECTION \_\_\_\_\_


B.C. TELEPHONE O/H UNDERGROUND CONNECTION \_\_\_\_\_

INLAND GAS AS SHOWN

Information Sheets: \_\_\_\_\_

Comments: \_\_\_\_\_

**THE INFORMATION CONTAINED HEREIN IS FOR INTERNAL USE ONLY.  
NOT TO BE RELIED UPON UNLESS CONFIRMED BY SITE INSPECTION AND/OR INVESTIGATION**

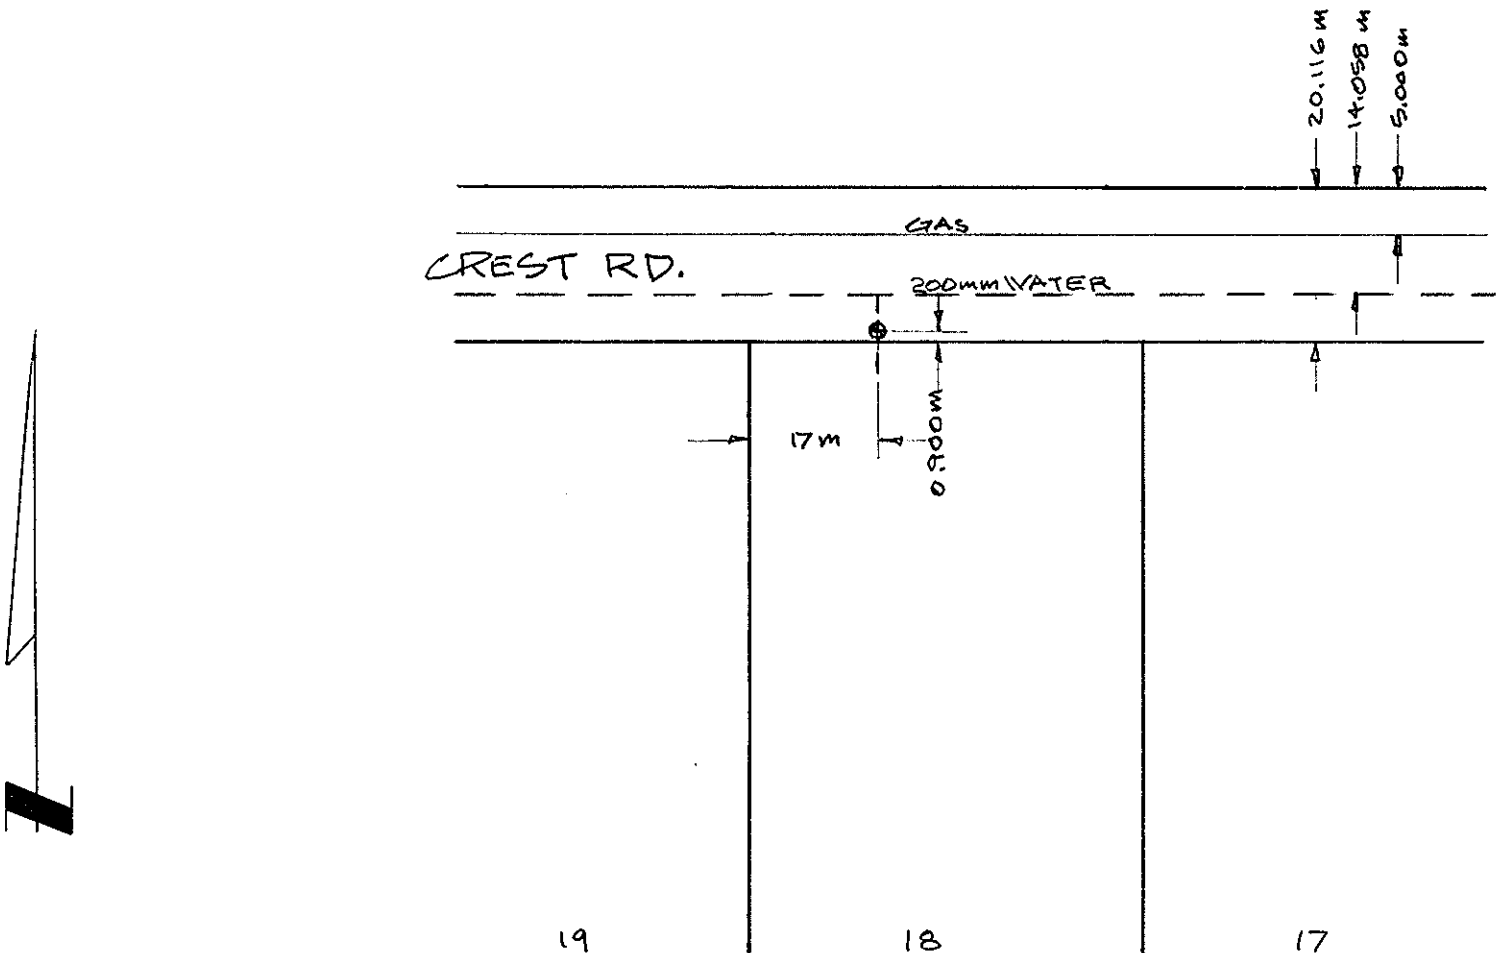

012107000

# REPORT TO RECORDS

7.

## WATER SERVICE INFORMATION

Lot No. \_\_\_\_\_ Block \_\_\_\_\_ D.L. \_\_\_\_\_


Address 4801 CREST.

Size of Connection ☐ 1/2" ☒ 3/4" ☐ Other \_\_\_\_\_

Type of Connection ☐ Copper ☐ Iron

Thaw Wire ☒ Yes ☐ No

### LOCATION SKETCH

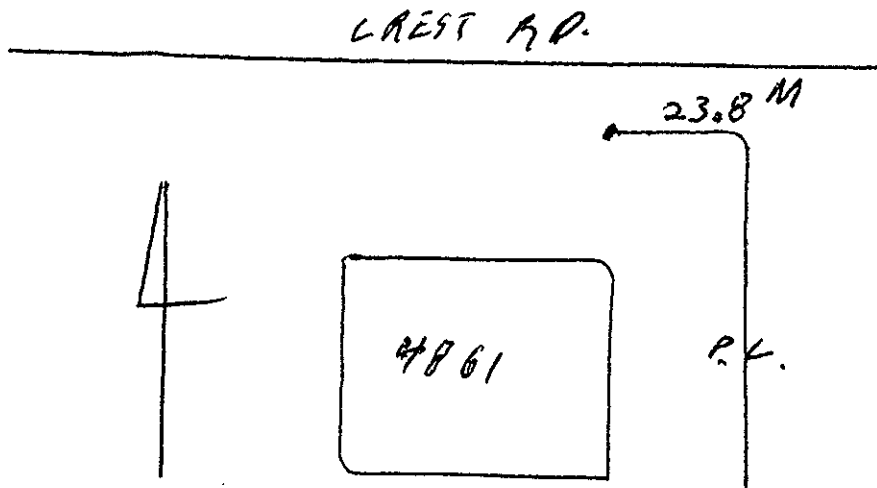

Field Location By Alvin H. Ritz Date Oct 21/94

Checked by: \_\_\_\_\_