



City of Prince George
History Sheet

PID:	012140520
SD/MU:	
WO:	

Civic Address: 8292 Cantle Dr

Legal Description: Lot: 1 District Lot: 625 Plan: 14430


Service Type	Diameter (mm)	Material	Invert Elev at main (m)	Invert Elev at property line (m)	Invert Elev at service end (m)	Distance into property (m)	Installation Date
Sanitary	100mm	AC	-	-	-	-	January 1981
Water	20mm	Copper	-	-	-	-	January 1981
Storm	N/A	N/A	-	-	-	-	

Service Connection Location					Sanitary (m)	Storm (m)
Distance from downstream San MH	4751	towards upstream San MH	4755		23.04	
Distance from downstream Stm MH	-	towards upstream Stm MH	-			

Power	Size	Communications	Size	Cable	Size	Gas	Size
BC Hydro	-	Telus	-	Shaw	-	FortisBC	-
Overhead Service		Overhead Service		Overhead Service			

Installed by:	Survey Date:	-
Comments:		

NOT TO SCALE The information contained herein is for internal use only.
Not to be relied on unless confirmed by site inspection and/or investigation.

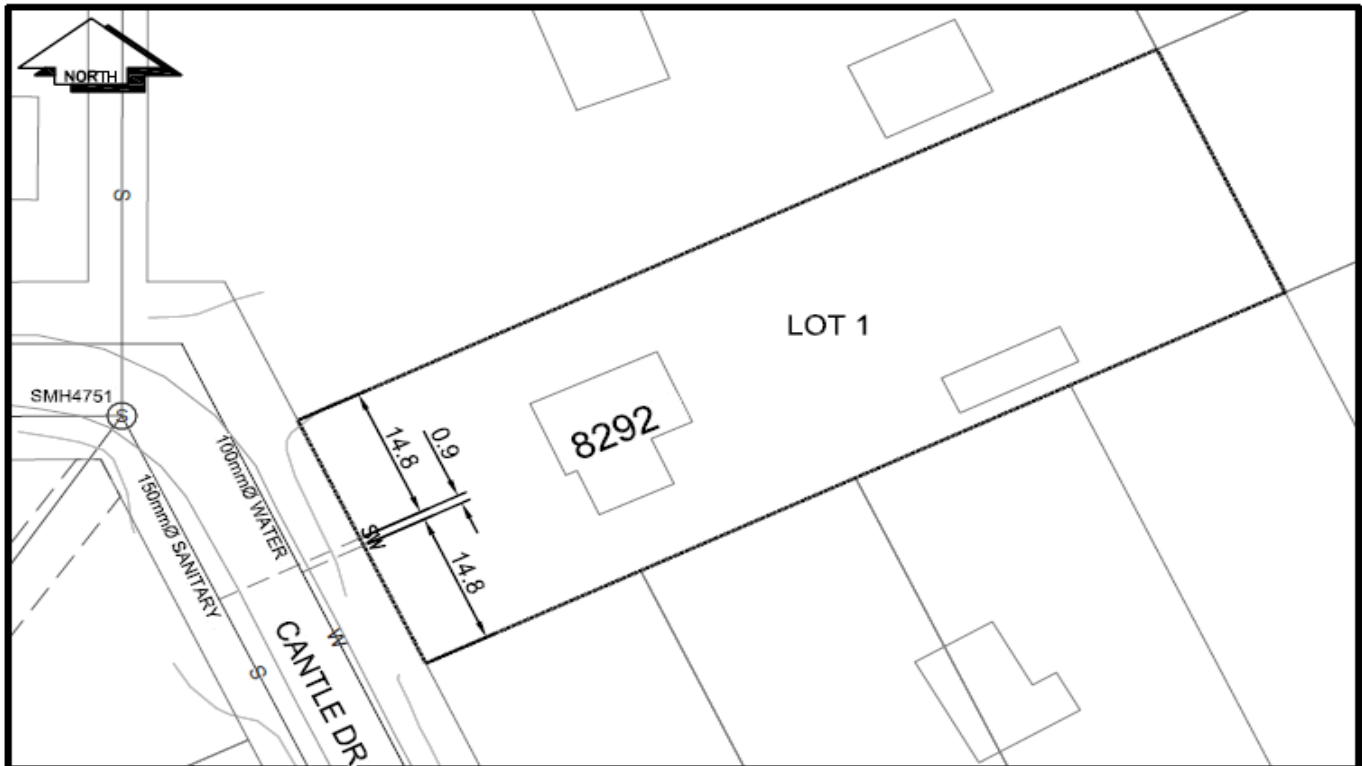

CS ^o CURB STOP	--- WATER SERVICE	--- S STORM SERVICE
CO ^o CLEAN OUT	--- S SANITARY SERVICE	--- G GAS

NOT TO SCALE