



City of Prince George History Sheet

PID:	012156621
SD/MU:	
CFS:	273470

Civic Address: 7881 Sabyam Rd

Legal Description: Lot: 22 District Lot: 2424 Plan: 9563


Service Type	Diameter (mm)	Material	Invert Elev at main (m)	Invert Elev at property line (m)	Depth of cut at property (m)	Distance into property (m)	Installation Date
Sanitary	100mm	PVC	-	754.11	3.02	-	July 1981
Water	20mm	Copper	-	-	-	-	
Storm	N/A	N/A	-	-	-	-	

Service Connection Location				Sanitary (m)	Storm (m)
Distance from downstream San MH	144	towards upstream San MH	127	85.40	
Distance from downstream Stm MH	-	towards upstream Stm MH	-	qsave	

Power	Size	Communications	Size	Cable	Size	Gas	Size
BC Hydro	-	Telus	-	Shaw	-	FortisBC	-
Overhead Service		Overhead Service		Overhead Service			

Installed by:		Survey Date:	-
Comments:	City of Prince George forces confirmed water service location May 4, 2014.		

NOT TO SCALE The information contained herein is for internal use only.
Not to be relied on unless confirmed by site inspection and/or investigation.

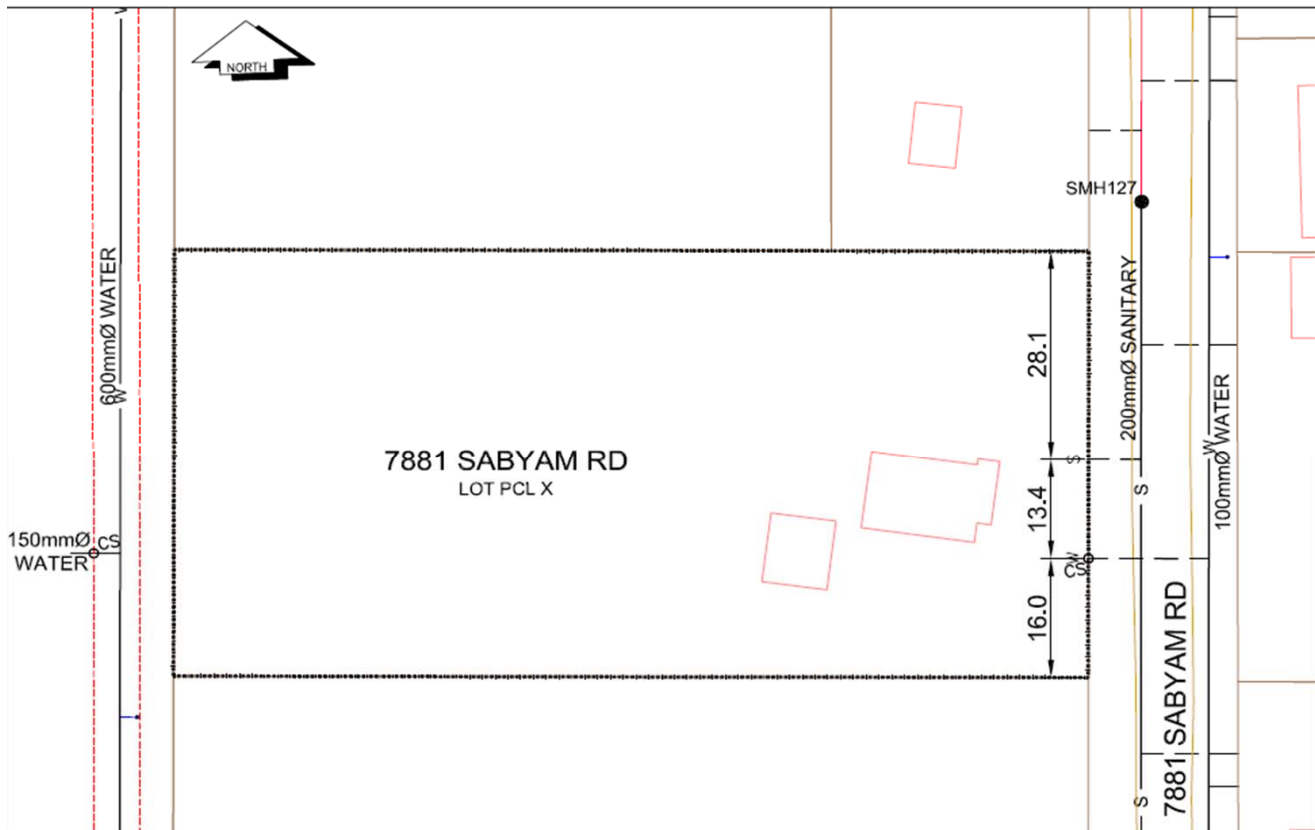

CS	CURB STOP	---	WATER SERVICE	---	STORM SERVICE
CO	CLEAN OUT	---	SANITARY SERVICE	---	GAS

NOT TO SCALE