CITY OF **PRINCE GEORGE** Civic Address: 8340 CANTLE DR

CITY OF PRINCE GEORG Civic Address: 8340 Legal Description: L	CANTLE DRIVE		30				WO:	5017852
Service Type	Diameter (mm)	Material	Invert Elev @ Main (m)	Invert Elev @ Property Line (m)		Invert Elev @ Service End (m)	Distance into Property (m)	Installation Date
Sanitary	100	PVC	743.03	743.32		Unknown	0.00	April 2020
Water	19	COPPER	Unknown	Unknown		Unknown	0.00	April 2020
Storm	N/A	-	-		-	-	-	-
Sanitary Service Connection Location Notes					Storm Service Connection Location Notes			
Distance from downstream SAN MH #4753: 84.98m					Distance from downstream STM MH #: N/A			

Distance to upstream STM MH #: N/A


Distance to upstream SAN MH #4752: 2.54m

			-						
Miscellaneous Utilities									
Power		Communications	Cable	Gas	Gas				
BC Hydro		TELUS	Shaw Cable	FortisBC					
Overhead Service		Overhead Service	Overhead Service	Underground Service					
Installation By:	City of Prince George			Survey Date:	2022-06-01				
		Comr	nents:						
Clean Out is ~12	.3m from the East prope	erty line of Lot 9. Curb Stop is ~12.7m from	the East property line of Lot 9. Services	s are center of Lot 9, side by	side.				
Inspection comple	eted 2021-08-16 as per	Inspection #4207887. Survey completed 2	2022-06-01.						

Lot Services Sketch

NOT TO SCALE The information contained herein is for internal use only.

Not to be relied on unless confirmed by site inspection and/or investigation.

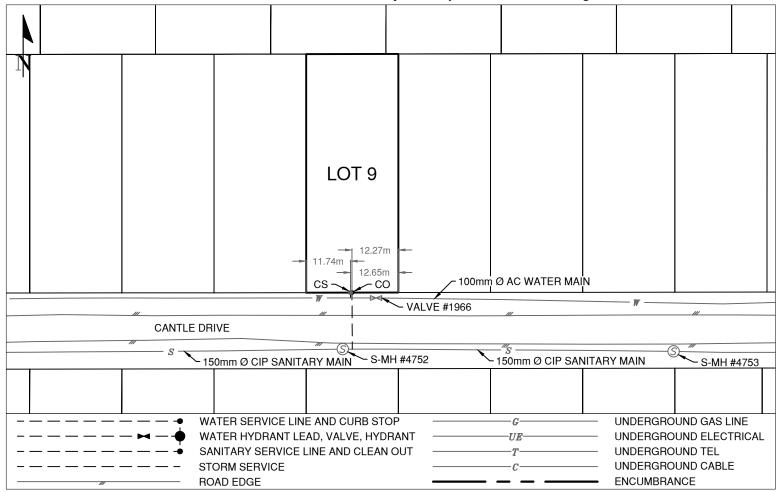



PID:	012198846
BU:	430100
WO:	5017852