



# City of Prince George History Sheet

PID:	012220205
SD/MU:	
WO:	

Civic Address: 4586 Heather Rd

Legal Description: Lot: 4 District Lot: 4048 Plan: 13971


Service Type	Diameter (mm)	Material	Invert Elev at main (m)	Invert Elev at property line (m)	Invert Elev at service end (m)	Distance into property (m)	Installation Date
Sanitary	100mm	PVC	-	-	-	-	January 1980
Water	20mm	Copper	-	-	-	-	January 1972
Storm	N/A	N/A	-	-	-	-	

Service Connection Location				Sanitary (m)	Storm (m)
Distance from downstream San MH	2912	towards upstream San MH	263	91.61	
Distance from downstream Stm MH	-	towards upstream Stm MH	-		

Power	Size	Communications	Size	Cable	Size	Gas	Size
BC Hydro	-	Telus	-	Shaw	-	FortisBC	-
Overhead Service		Overhead Service		Overhead Service			

Installed by:	.	Survey Date:	-
Comments:	Water service confirmed April 18, 2017		

**NOT TO SCALE** The information contained herein is for internal use only.  
Not to be relied on unless confirmed by site inspection and/or investigation.

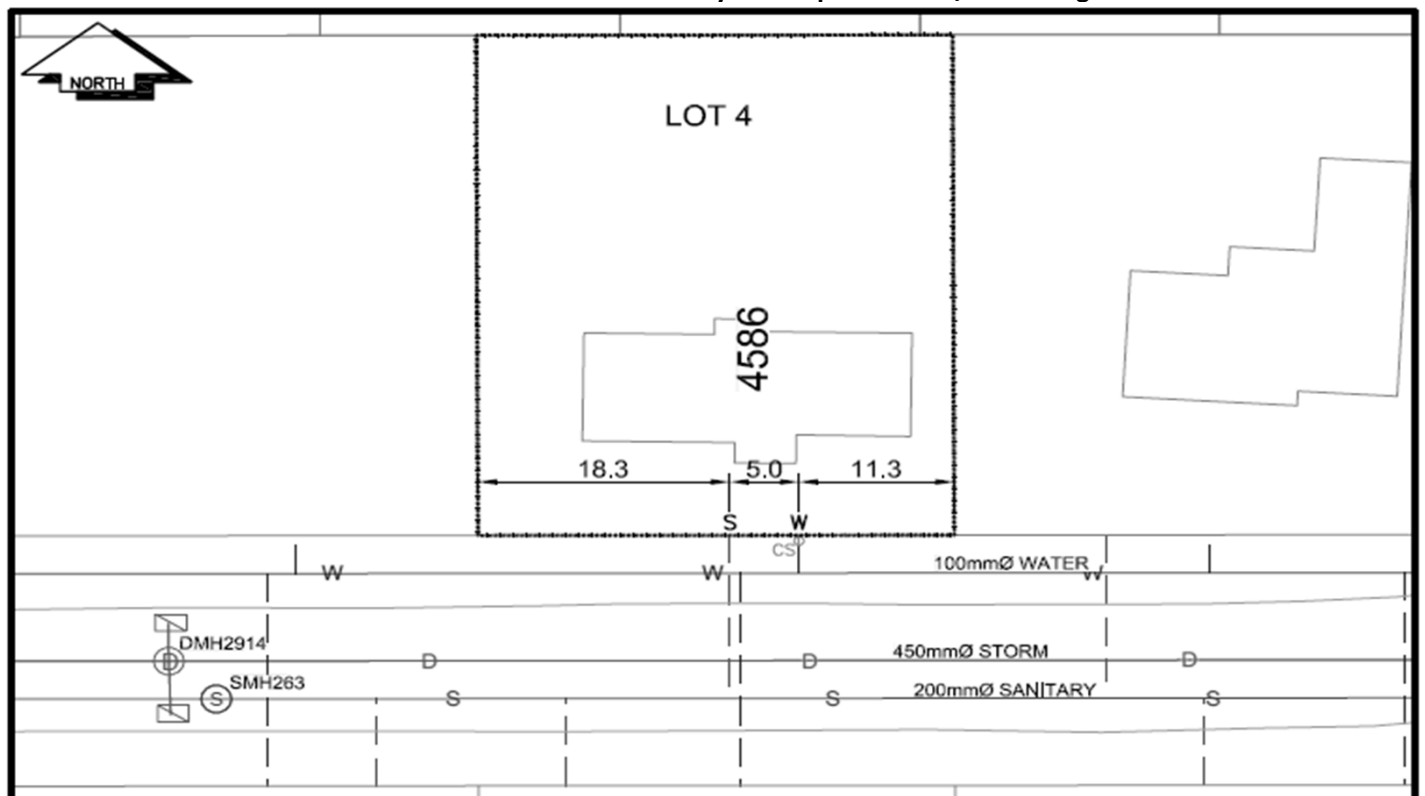

CS <sup>o</sup> CURB STOP	--- W --- WATER SERVICE	--- S --- STORM SERVICE
CO <sup>o</sup> CLEAN OUT	--- S --- SANITARY SERVICE	--- G --- GAS
WV WATER VALVE	⊗ FIRE HYDRANT	--- --- ENCUMBRANCE

**NOT TO SCALE**