


Lot Servicing

3883 HAMMOND AVE

PID: 012260142

Lot: 25, Plan: 13198, DL: 938

| SERVICE | SIZE | MATERIAL | INSTALLED DATE | LOCATION | DETAILS |
|----------|---------|----------|----------------|--------------------------------|---------------------------|
| WATER | 19MM | UNKNOWN | 01-Jan-1963 | FR NW COR BLD 8.1M W 3.0M S | CONNECTION NUMBER 3643 |
| SANITARY | UNKNOWN | UNKNOWN | | 9.144M S OF NW COR PL | CONNECTION # 3643 |
| | | | | | |
| | | | | | |

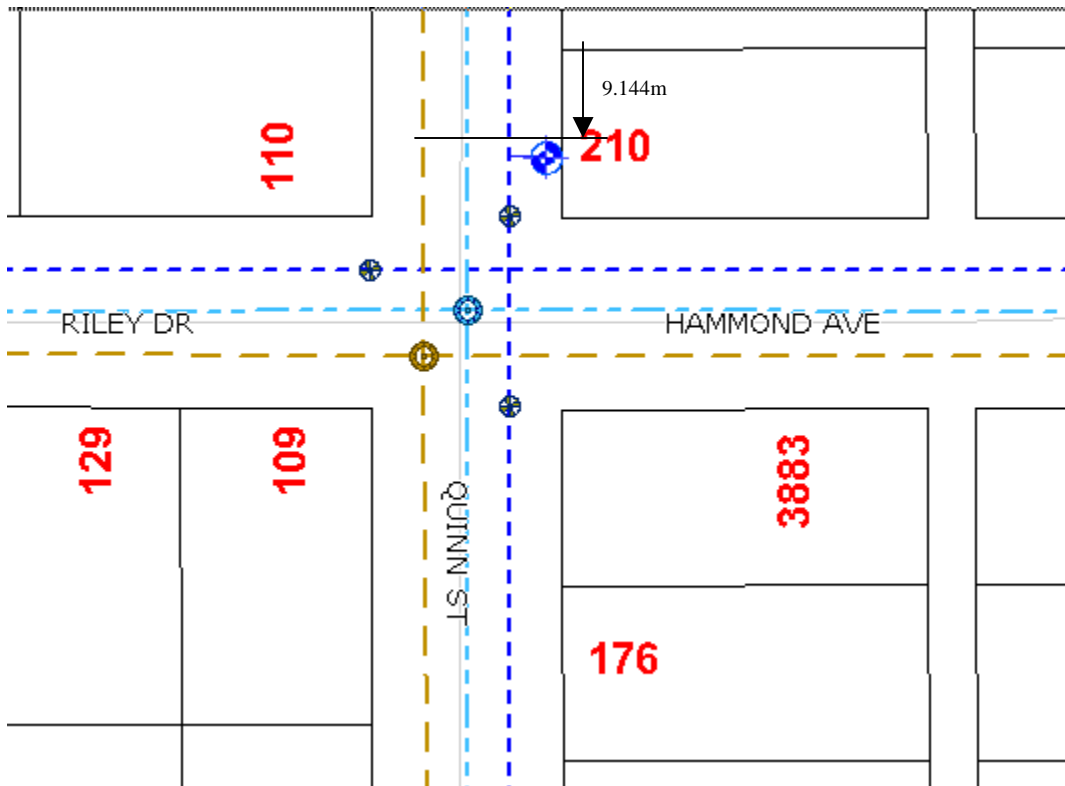

Accuracy not guaranteed unless confirmed by site inspection and/or investigation.
Connection location between main and property line only.