



City of Prince George
History Sheet

PID:	012261246
MU:	101175
WO:	58962/58963

Civic Address: 3224 Blackburn Rd
Legal Description: Lot: 3 District Lot: 1545 Plan: 13257


Service Type	Diameter (mm)	Material	Invert Elev at main (m)	Invert Elev at property line (m)	Invert Elev at service end (m)	Distance into property (m)	Installation Date
Sanitary	100mm	PVC	1.00	1.25	2.00	3.00	May 2011
Water	20mm	Copper	-	-	-	-	May 2011
Storm	N/A	N/A	-	-	-	-	

Service Connection Location				Sanitary (m)	Storm (m)
Distance from downstream San MH	1814	towards upstream San MH	1815	29.28	
Distance from downstream Stm MH	-	towards upstream Stm MH	-		

Power	Size	Communications	Size	Cable	Size	Gas	Size
BC Hydro	-	Telus	-	Shaw	-	FortisBC	-
Overhead Service		Overhead Service		Overhead Service			

Installed by:	City of Prince George forces	Survey Date:	-
Comments:			

NOT TO SCALE The information contained herein is for internal use only.
Not to be relied on unless confirmed by site inspection and/or investigation.

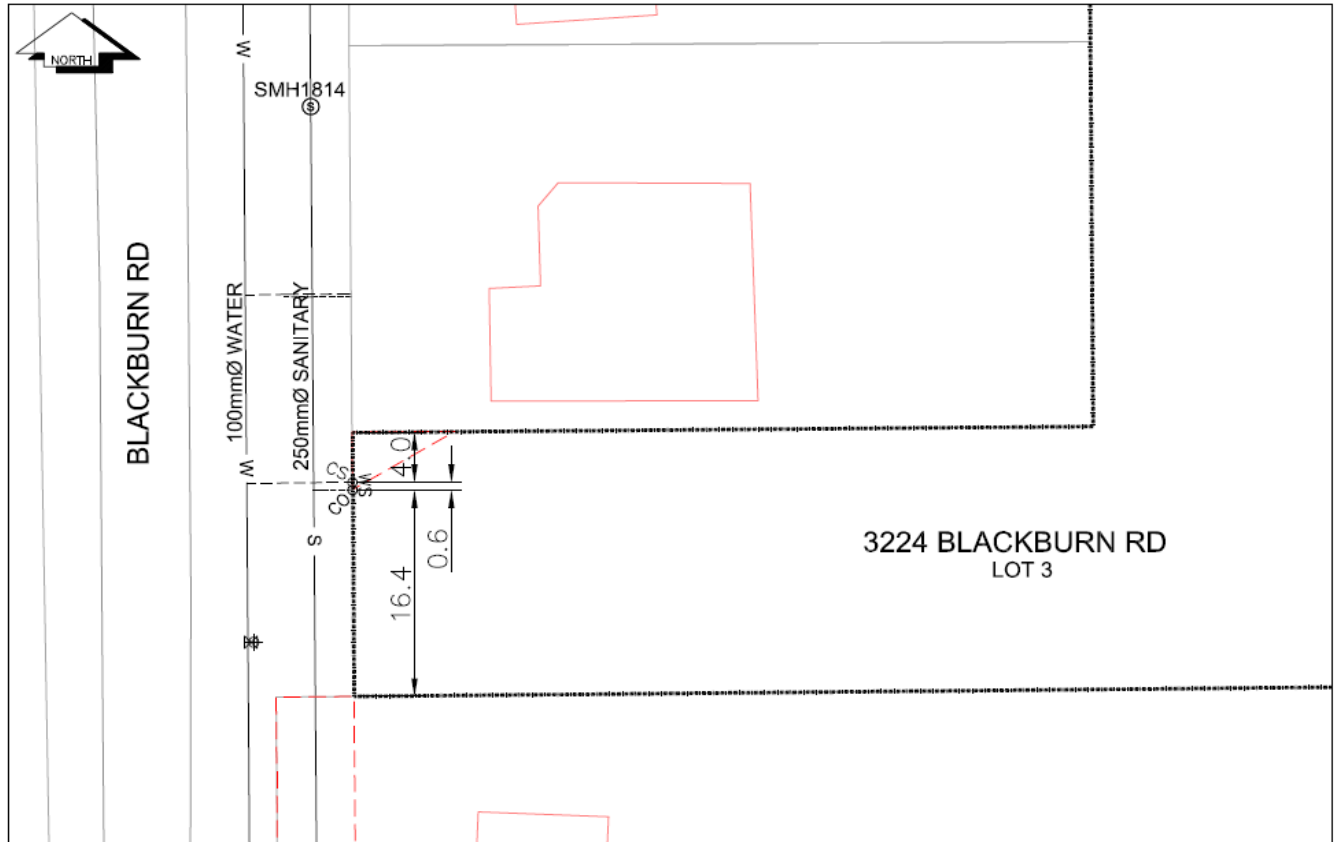

LEGEND:	CS ^o CURB STOP	--- W WATER SERVICE	--- S STORM SERVICE
	CO ^o CLEAN OUT	--- S SANITARY SERVICE	⊗ WATER VALVE

NOT TO SCALE