
CITY OF PRINCE GEORGE Civic Address: 8250 CORRAL RD

PID:	012272612
BU:	411197 / 314297
WO:	-

Legal Description: Lot: 9 District Lot: 625 Plan: 13646

Service Type	Diameter (mm)	Material	Invert Elev @ Main (m)		rt Elev @ rty Line (m)	Invert Elev @ Service End (m)	Distance Property		stallation Date
Sanitary	100 (Inoperable)	AC	471.1	Unknown		Unknown	Unknown J		anuary 1977
Water	19 (Inoperable)	COPPER	Unknown	Unknown		Unknown	Unknow	Unknown January	
Storm	N/A	-	-	-		-	-		-
Sanita	ry Service Con	nection Loo	cation Notes		S	torm Service Conn	ection Loo	cation Not	es
Distance from downstream SAN MH: 26.00m				Distance from downstream STM MH: N/A					
Distance to upstream SAN MH: 103.44m North & 108.05m East			Distance to upstream STM MH: N/A						
			Mise	cellaned	ous Utilities				
Power Communications		Cable		Gas					
BC H	lydro		TELUS			Shaw Cable FortisBC			;
Overhea	Overhead Service Overhead Service Underground				nderground S	ervice			
Installation By:	nstalled by City of P	rince George.			Survey I			urvey Date:	2021-08-16
L				Com	nents:		ľ		
Water curb stop and	d Sanitary clean out	at South-East	corner of property.	Services	are side by side.				
Inspection #420789	2 complete 2021-08	3-16. Water and	Sanitary services	are inope	rable.				
						n is for internal us ction and/or inves	•		

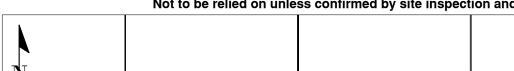

№						
	LOT	9	MAIN			
			200mm Ø AC SANITARY MAIN			
	⊲ 45.11m	0.30m -	Q Q U U C URB STOP			
		CLEAN OUT 🔨	/150mm Ø AC SANITARY MA	NN-		
()	100mm Ø SANITAR	/ SERVICE)/	<i>S</i>		
S-MH#4743	150mm Ø AC SANITARY MAIN S-MH#4745		S-MH#4742 CORR	AL RD		
	200mm Ø AC SANITARY MAIN —-		└─ 19mm Ø WATER SERVI	Ø AC WATER MAIN CE		
			AC SANITARY MAIN			
	WATER SERVICE LINE AND CURB STOP			JNDERGROUND GAS LINE		
	— 🛏 — — 🌩 🛛 WATER HYDRANT LEAD, VALVE, HYDRA	NT	<i>UE</i> L	JNDERGROUND ELECTRICAL		
	SANITARY SERVICE LINE AND CLEAN O	JT —		JNDERGROUND TEL		
	STORM SERVICE		— — — — E	ENCUMBERANCE		