



City of Prince George History Sheet

PID:	012288276
SD/MU:	
WO:	

Civic Address: 8350 Cattle Dr

Legal Description: Lot: 11 District Lot: 625 Plan: 14430


Service Type	Diameter (mm)	Material	Invert Elev at main (m)	Invert Elev at property line (m)	Invert Elev at service end (m)	Distance into property (m)	Installation Date
Sanitary	100mm	AC	-	-	-	-	December 1980
Water	Unknown	Unknown	-	-	-	-	December 1980
Storm	N/A	N/A	-	-	-	-	

Service Connection Location				Sanitary (m)	Storm (m)
Distance from downstream San MH	4749	towards upstream San MH	4748	34.90	
Distance from downstream Stm MH	-	towards upstream Stm MH	-		

Power	Size	Communications	Size	Cable	Size	Gas	Size
BC Hydro	-	Telus	-	Shaw	-	FortisBC	-
Overhead Service		Overhead Service		Overhead Service			

Installed by:	Survey Date:	-
Comments:		

NOT TO SCALE The information contained herein is for internal use only.
Not to be relied on unless confirmed by site inspection and/or investigation.

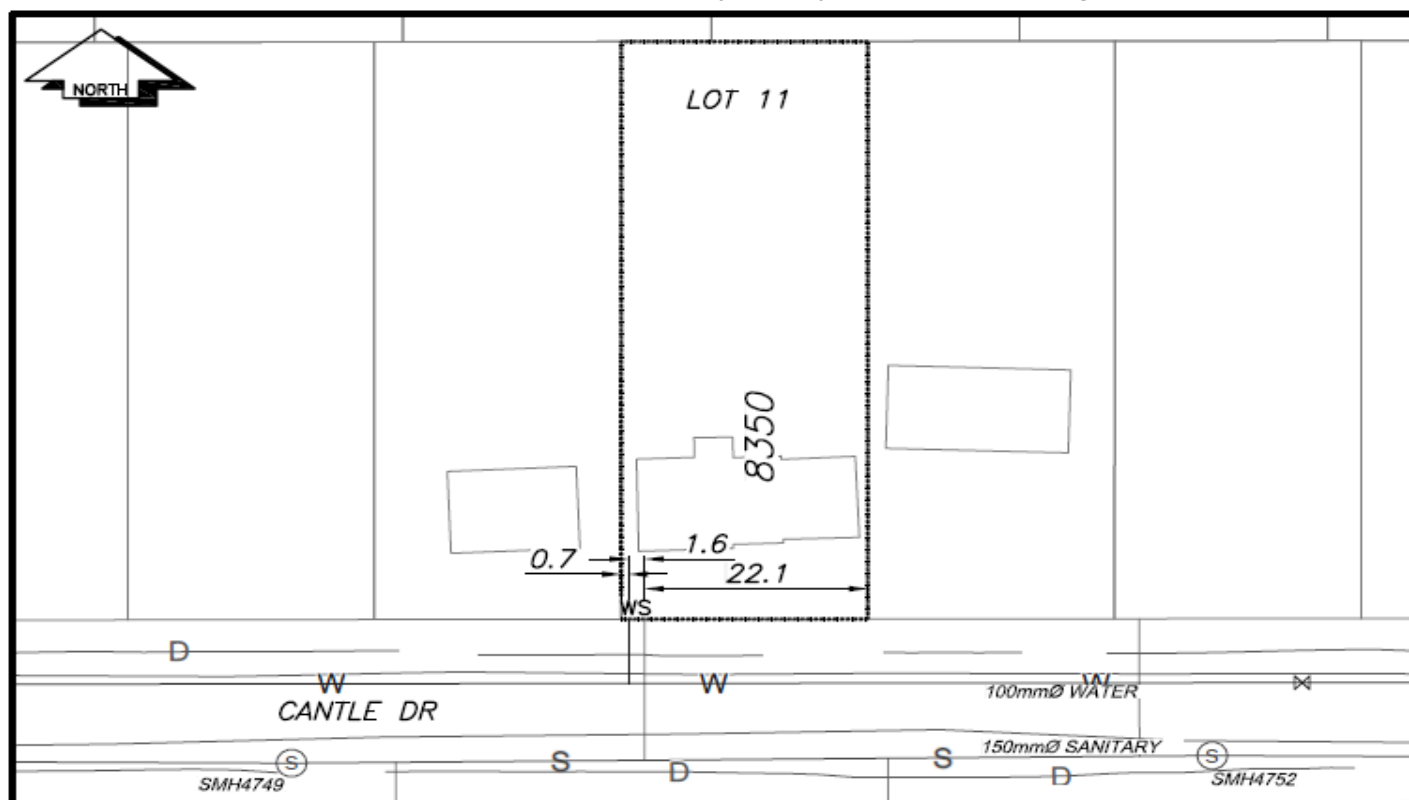

CS CURB STOP	W WATER SERVICE	S STORM SERVICE
CO CLEAN OUT	S SANITARY SERVICE	G GAS
WATER VALVE	FH FIRE HYDRANT	ENCUMBRANCE

NOT TO SCALE