



City of Prince George
History Sheet

PID:	012327832
MU:	101470
WO:	

Civic Address: 2920 Spruce St

Legal Description: Lot: 3 except Plan EPP45418 District Lot: 913 Plan: 13


Service Type	Diameter (mm)	Material	-	Depth of Cut at property line (m)	Invert Elev at service end (m)	Distance into property (m)	Installation Date
Sanitary	100mm	PVC	-	1.83	554.59	3.00	January 1970
Water	20mm	Copper	-	-	-	-	January 1970
Storm	N/A	N/A	-	-	-	-	

Service Connection Location				Sanitary (m)	Storm (m)
Distance from downstream San MH	3855	towards upstream San MH	3855	0.00	
Distance from downstream Stm MH	-	towards upstream Stm MH	-		

Power	Size	Communications	Size	Cable	Size	Gas	Size
BC Hydro	-	Telus	-	Shaw	-	FortisBC	-
Overhead Service		Overhead Service		Overhead Service			

Installed by:	Survey Date:	August 1970
Comments:		

NOT TO SCALE The information contained herein is for internal use only.
Not to be relied on unless confirmed by site inspection and/or investigation.

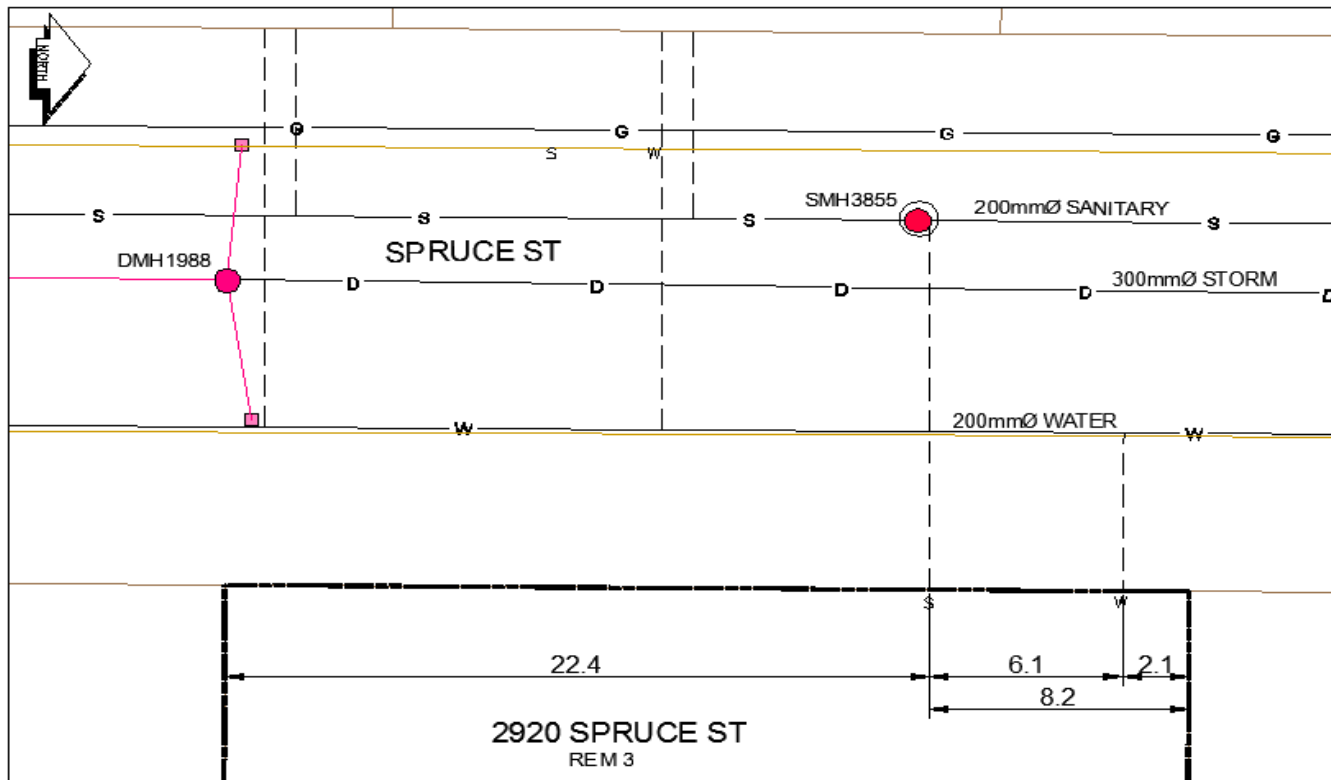

LEGE ND:	CS ^o CURB STOP	--- WATER SERVICE	--- STORM SERVICE
	CO ^o CLEAN OUT	--- SANITARY SERVICE	--- GAS

NOT TO SCALE