


Lot Servicing

5697 HEYER RD

PID: 012348848

Lot: E, Plan: 13051, DL: 1599

SERVICE	SIZE	MATERIAL	INSTALLED DATE	LOCATION	DETAILS
WATER	20MM	CU	07-Aug-1979	No location - Bldg demolished 2009	CASH RECEIPT NUMBER 2111
SANITARY	100MM	PVC	01-Oct-2001	1.67M W OF E P/L; SEP-04 4.7M W E PL	CLEANOUT 9.8M S OF SE COR BLDG

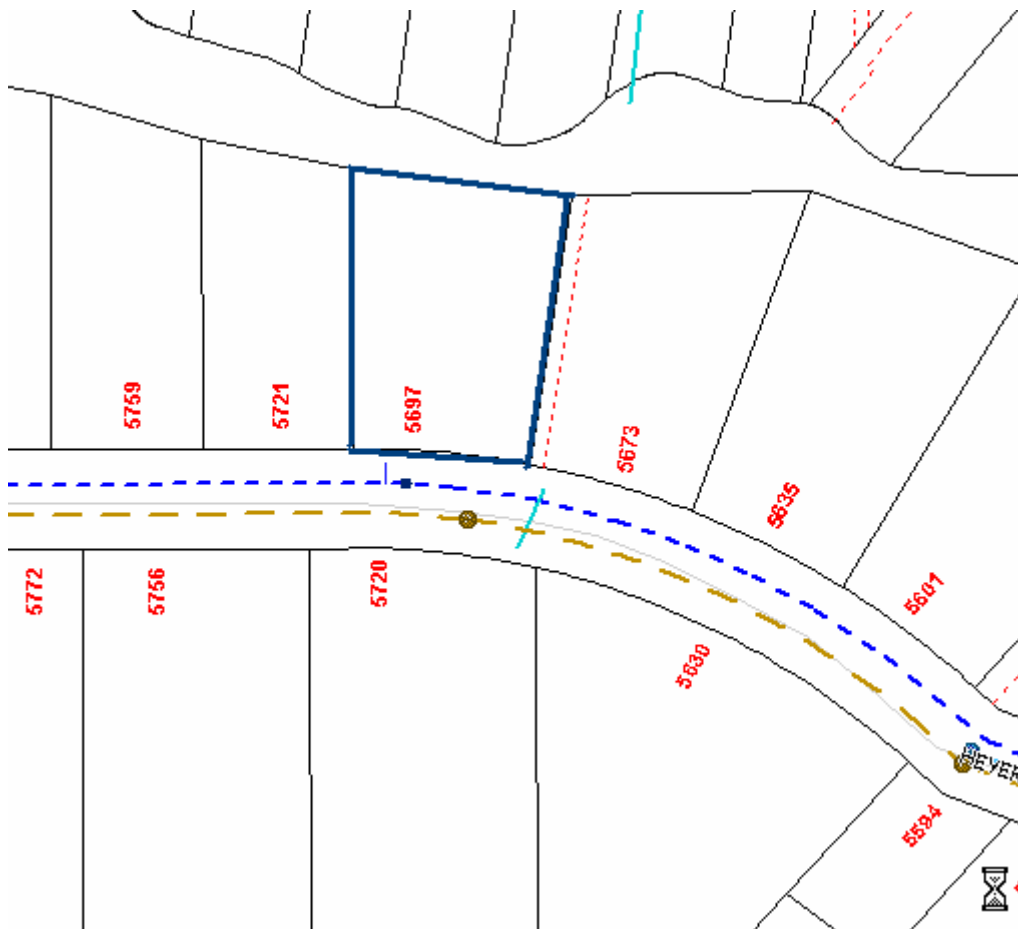

Accuracy not guaranteed unless confirmed by site inspection and/or investigation.
Connection location between main and property line only.