

| | |
|--------|-----------|
| PID: | 012408603 |
| | 012408590 |
| SD/MU: | |
| WO: | |

Civic Address: 810 Central St E

Legal Description: Lot: A, B District Lot: 936 Plan: 12202


| Service Type | Diameter (mm) | Material | Invert Elev at main (m) | Invert Elev at property line (m) | Invert Depth at service end (m) | Distance into property (m) | Installation Date |
|--------------|---------------|----------|-------------------------|----------------------------------|---------------------------------|----------------------------|-------------------|
| Sanitary | 100mm | AC | 596.87 | - | 2.44 | - | January 1961 |
| Water | 40mm | Copper | - | - | - | - | January 1960 |
| Storm | N/A | N/A | - | - | - | - | |

| Service Connection Location | | | | Sanitary (m) | Storm (m) |
|---------------------------------|------|-------------------------|------|--------------|-----------|
| Distance from downstream San MH | 1948 | towards upstream San MH | 1457 | 9.83 | |
| Distance from downstream Stm MH | - | towards upstream Stm MH | - | | |

| Power | Size | Communications | Size | Cable | Size | Gas | Size |
|------------------|------|------------------|------|------------------|------|----------|------|
| BC Hydro | - | Telus | - | Shaw | - | FortisBC | - |
| Overhead Service | | Overhead Service | | Overhead Service | | | |

| | | |
|---|--------------|---|
| Installed by: | Survey Date: | - |
| Comments: Water service location confirmed April 13, 2017 | | |
| | | |
| | | |

NOT TO SCALE The information contained herein is for internal use only.
Not to be relied on unless confirmed by site inspection and/or investigation.

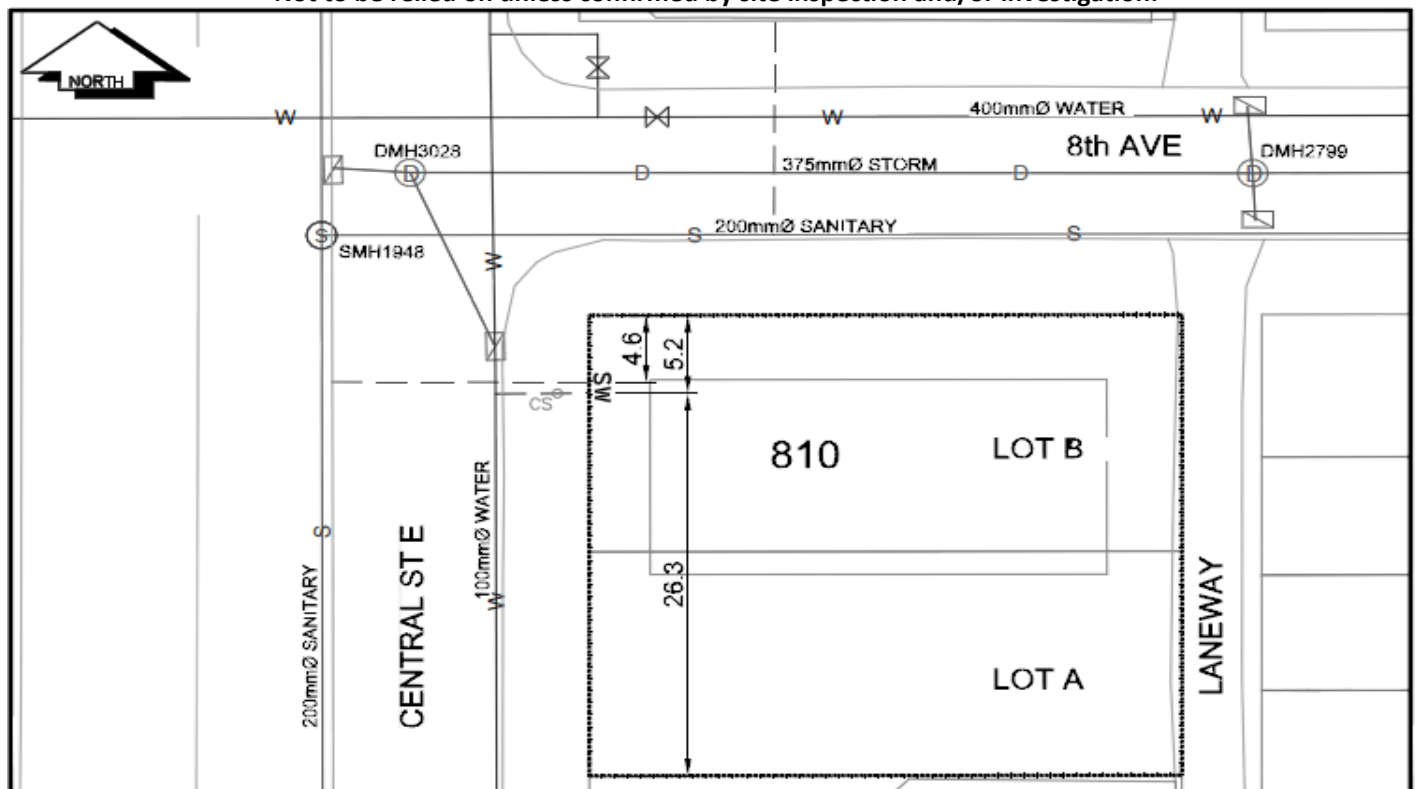

| | | | | | | | |
|----|-------------|-----|---|------------------|-----|-----|---------------|
| CS | CURB STOP | --- | W | WATER SERVICE | --- | ⊕ | STORM SERVICE |
| CO | CLEAN OUT | --- | S | SANITARY SERVICE | --- | G | GAS |
| ⊗ | WATER VALVE | --- | ⊕ | FIRE HYDRANT | --- | --- | ENCUMBRANCE |

NOT TO SCALE