



City of Prince George  
**History Sheet**

PID:	012521787
SD/MU:	
WO:	

Civic Address: 2869 Hopkins Rd

Legal Description: Lot: 1 District Lot: 1433 Plan: 11794


Service Type	Diameter (mm)	Material	Invert Elev at main (m)	Invert Depth at property line (m)	Invert Depth at service end (m)	Distance into property (m)	Installation Date
Sanitary	100mm	PVC	-	590.45	2.79	-	December 1979
Water	20mm	Copper	-	-	-	-	December 1979
Storm	N/A	N/A	-	-	-	-	

Service Connection Location				Sanitary (m)	Storm (m)
Distance from downstream San MH	1862	towards upstream San MH	4085	26.47	
Distance from downstream Stm MH	-	towards upstream Stm MH	-		

Power	Size	Communications	Size	Cable	Size	Gas	Size
BC Hydro	-	Telus	-	Shaw	-	FortisBC	-
Overhead Service		Overhead Service		Overhead Service			

Installed by:	Survey Date:	-
Comments:		

**NOT TO SCALE** The information contained herein is for internal use only.  
Not to be relied on unless confirmed by site inspection and/or investigation.

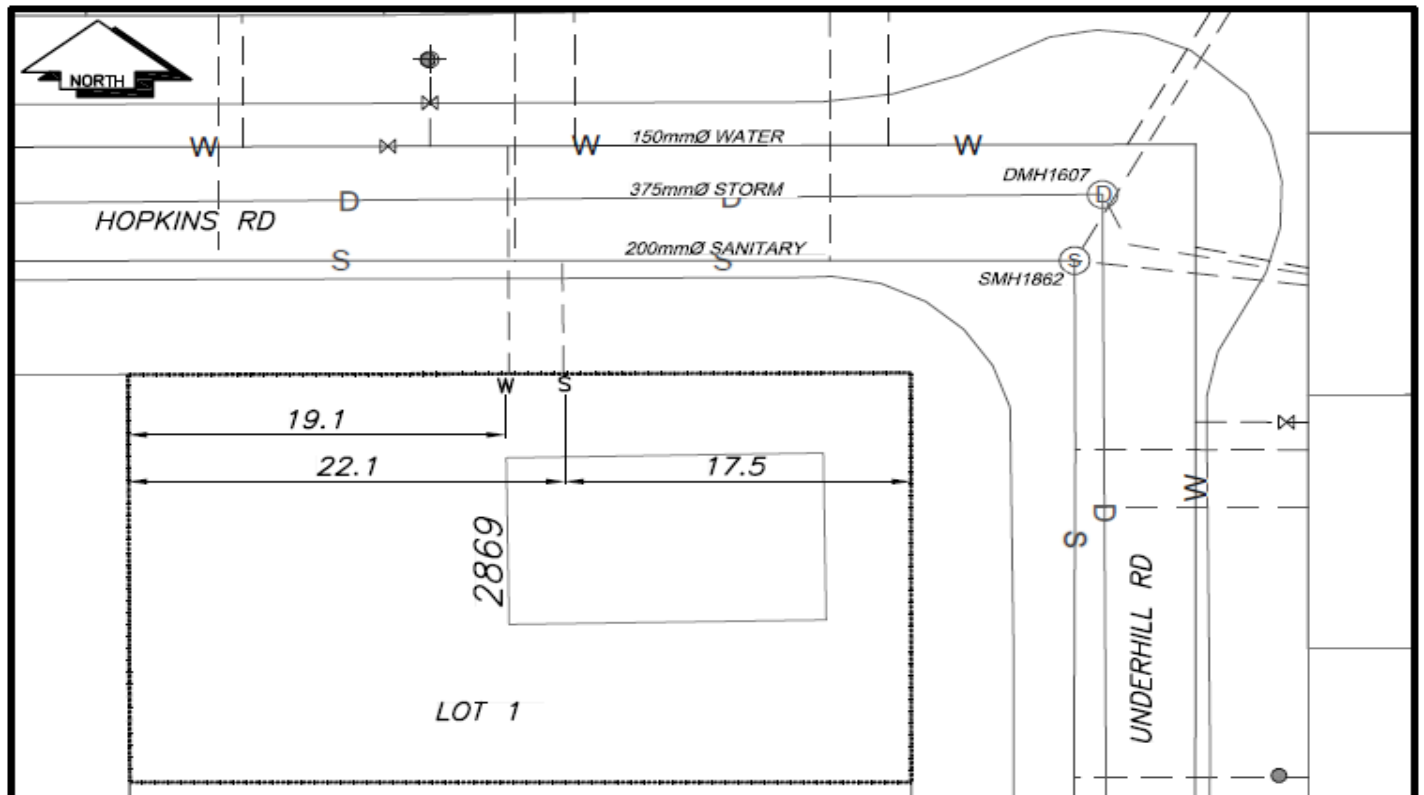

LEGEND:			
CS	CURB STOP	—=—	WATER SERVICE
CO	CLEAN OUT	- - - -	SANITARY SERVICE
⊗	WATER VALVE	⊗	FIRE HYDRANT
		—○—	STORM SERVICE
		—G—	GAS
		- - - -	ENCUMBRANCE

**NOT TO SCALE**