



# City of Prince George History Sheet

PID:	012525430
MU:	102192
WO:	100285/100286

Civic Address: 4787 Martin Rd

Legal Description: Lot: A District Lot: 2424 Plan: 11436


Service Type	Diameter (mm)	Material	Invert Elev at main (m)	Invert Elev at property line (m)	Invert Elev at service end (m)	Distance into property (m)	Installation Date
Sanitary	100mm	PVC	-	756.01	756.07	1.00	August 2019
Water	20mm	Copper	756.94	756.17	756.19	1.00	August 2019
Storm	N/A	N/A		-	-	-	

Service Connection Location	Sanitary (m)	Storm (m)
100Mmm Sanitary service connected to San Mh21	-	
Distance from downstream Stm MH - towards upstream Stm MH -		

Power	Size	Communications	Size	Cable	Size	Gas	Size
BC Hydro	-	Telus	-	Shaw	-	FortisBC	-
Overhead Service		Overhead Service		Overhead Service			

Installed by: City of Prince George forces	Survey Date: -
Comments:	

**NOT TO SCALE** The information contained herein is for internal use only.  
Not to be relied on unless confirmed by site inspection and/or investigation.

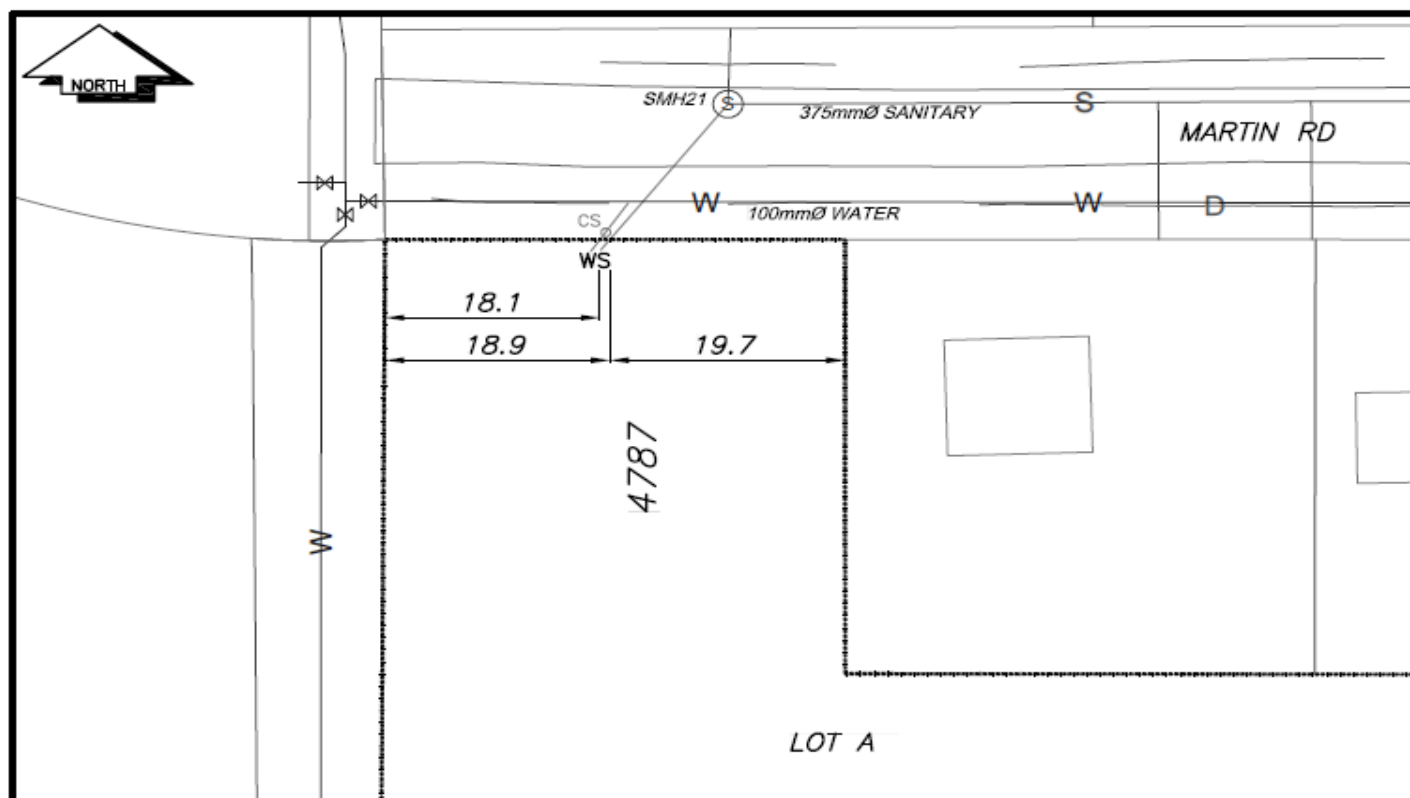

CS CURB STOP	— WATER SERVICE	— STORM SERVICE
CO CLEAN OUT	- - - - - SANITARY SERVICE	— G — GAS
⊗ WATER VALVE	⊗ FIRE HYDRANT	- - - - - ENCUMBRANCE

**NOT TO SCALE**