



# City of Prince George History Sheet

PID:	012538825
SD/MU:	100464/101608
WO:	89479/89483
	89481

Civic Address: 2910 Charella Dr  
4070 Davis Rd

Legal Description: Lot: 35 District Lot: 9261 Plan: 11361


Service Type	Diameter (mm)	Material	Invert Elev at main (m)	Invert Elev at property line (m)	Invert Depth at service end (m)	Distance into property (m)	Installation Date
Sanitary (south)	100mm	PVC	-	-	2.52	-	December 1979
Sanitary (west)	100mm	PVC	-	653.89	-	-1.10	September 2016
Water (south)	20mm	Copper	-	-	-	-	December 1979
Water (west)	20mm	Copper	-	653.83	-	-	September 2016
Storm	100mm	PVC	-	653.88	-	-0.70	September 2016

Service Connection Location				Sanitary (m)	Storm (m)
Distance from downstream San MH	3611	towards upstream San MH	3612	61.70	
Distance from downstream San MH	3564	towards upstream San MH	3640	124.57	
Distance from downstream Stm MH	1804	towards upstream Stm MH	1807		121.60

Power	Size	Communications	Size	Cable	Size	Gas	Size
BC Hydro	-	Telus	-	Shaw	-	FortisBC	-
Overhead Service		Overhead Service		Overhead Service			

Installed by:	City of Prince George forces	Survey Date:	-
Comments:			

**NOT TO SCALE** The information contained herein is for internal use only.  
Not to be relied on unless confirmed by site inspection and/or investigation.

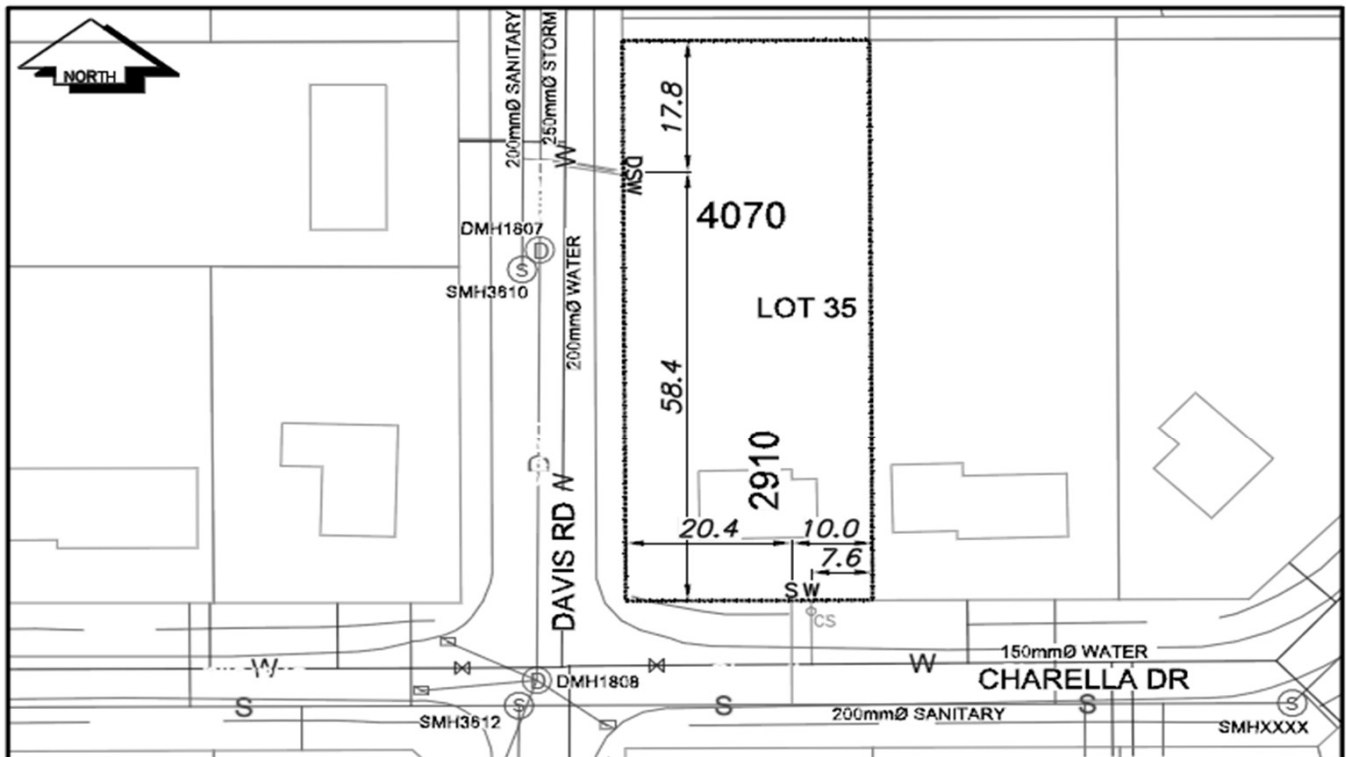

CS CURB STOP	W WATER SERVICE	STORM SERVICE
CO CLEAN OUT	S SANITARY SERVICE	G GAS
WATER VALVE	FIRE HYDRANT	ENCUMBRANCE

**NOT TO SCALE**