



City of Prince George
History Sheet

PID:	012558052
SD/MU:	
WO:	

Civic Address: 4225 - 4251 Turner Rd

Legal Description: Lot: 23 District Lot: 4047 Plan: 11060


Service Type	Diameter (mm)	Material	Invert Elev at main (m)	Invert Elev at property line (m)	Invert Elev at service end (m)	Distance into property (m)	Installation Date
Sanitary	N/A	N/A	-	-	-	-	-
Water	20mm	Copper	-	-	-	-	-
Storm	N/A	N/A	-	-	-	-	-

Service Connection Location					Sanitary (m)	Storm (m)
Distance from downstream San MH			-	towards upstream San MH	-	-
Distance from downstream Stm MH			-	towards upstream Stm MH	-	-

Power	Size	Communications	Size	Cable	Size	Gas	Size
BC Hydro	-	Telus	-	Shaw	-	FortisBC	-
Overhead Service		Overhead Service		Overhead Service			

Installed by:		Survey Date:	-
Comments:	City forces confirmed no sanitary service - February 25, 2013		

NOT TO SCALE The information contained herein is for internal use only.
Not to be relied on unless confirmed by site inspection and/or investigation.

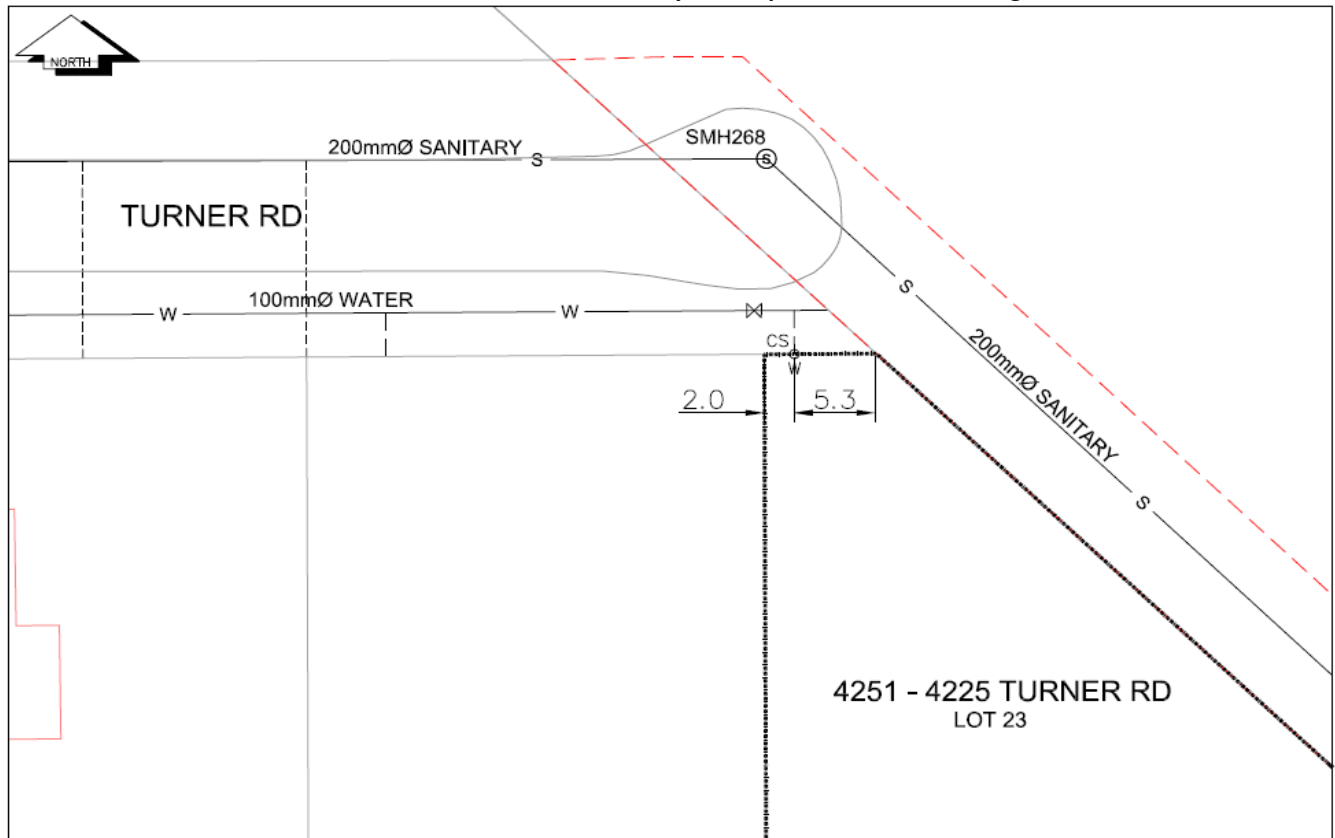

LEGEND:	CS ^o CURB STOP	--- W WATER SERVICE	--- S STORM SERVICE
	CO ^o CLEAN OUT	--- S SANITARY SERVICE	⊗ WATER VALVE

NOT TO SCALE