



City of Prince George
History Sheet

PID:	012582204
SD/MU:	
WO:	

Civic Address: 1722, 1738 Ogilvie St

Legal Description: Lot: 28 District Lot: 936 Plan: 10868


Service Type	Diameter (mm)	Material	Invert Elev at main (m)	Invert Elev at property line (m)	Invert Elev at service end (m)	Distance into property (m)	Installation Date
Sanitary	100mm	AC	-	602.24	-	-	January 1967
Water	40mm	Copper	-	-	-	-	January 1964
Storm	150mm	AC	-	-	-	-	January 1973

Service Connection Location				Sanitary (m)	Storm (m)
Distance from downstream San MH	4036	towards upstream San MH	4038	44.14	-
Distance from downstream Stm MH	2140	towards upstream Stm MH	2136	-	80.28

Power	Size	Communications	Size	Cable	Size	Gas	Size
BC Hydro	-	Telus	-	Shaw	-	FortisBC	-
Overhead Service		Overhead Service		Overhead Service			

Installed by:	Survey Date:	-
Comments:		

NOT TO SCALE The information contained herein is for internal use only.
Not to be relied on unless confirmed by site inspection and/or investigation.

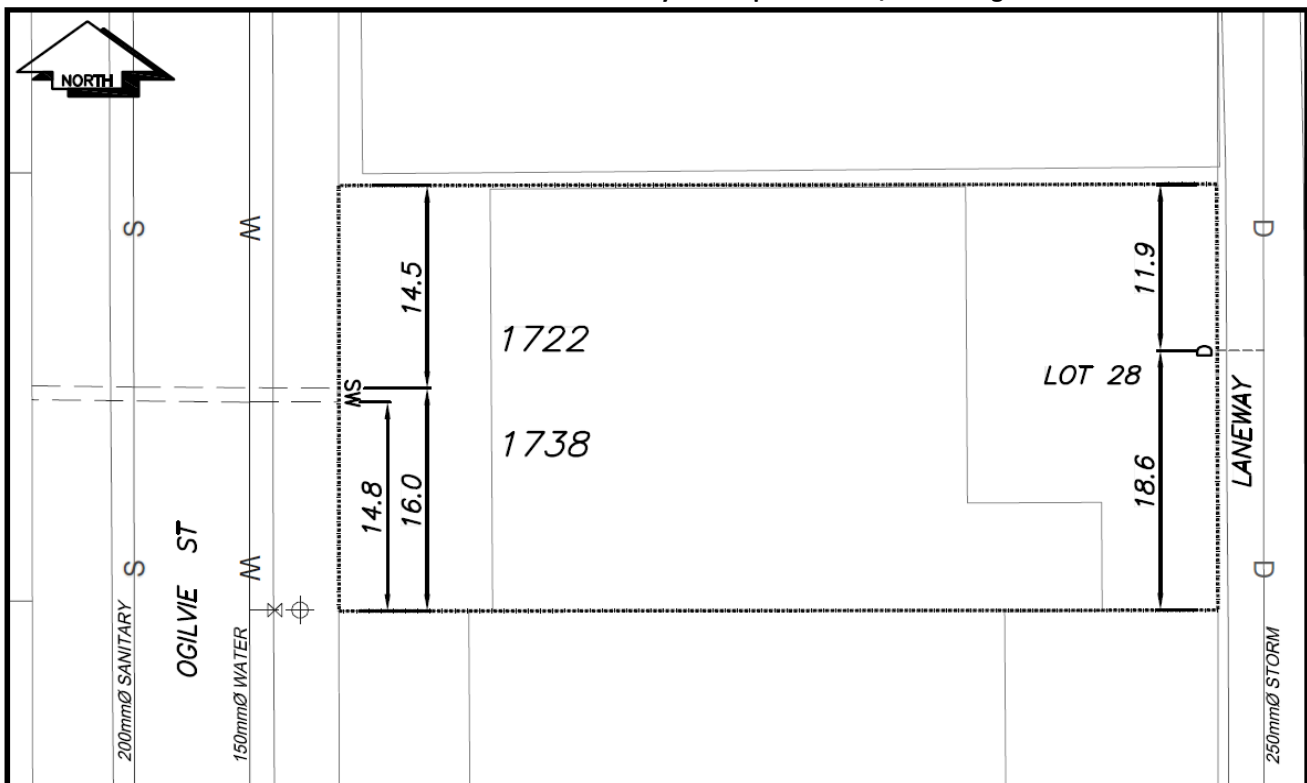

CS ^o	CURB STOP	—W—	WATER SERVICE	—S—	STORM SERVICE
CO ^o	CLEAN OUT	---S---	SANITARY SERVICE	—G—	GAS
⊗	WATER VALVE	—F—	FIRE HYDRANT	---	ENCUMBERANCE

NOT TO SCALE