
City of Prince George HISTORY SHEET

PID:	012583413	3				Scale	e: 1:1000)		
Legal:	23					D.L.:	2424		PLAN: 10807	
Address:	5118 CHIE	F LAKE RO	DAD							
Sanitary	Connection:	16643	SIZE:	100mmØ	MATERIAL:	PVC	INV.		CONNECTED	
Water Co	onnection:		SIZE:	19mmØ	MATERIAL:	COPPER	INV.	761.59m	CONNECTED	
Storm Co	onnection:		SIZE		MATERIAL		INV.			
Cash Re	ceipt No's:			WATER		SANITARY			STORM	
CURB FROM PROPERTY LINE				PAVEMENT WIDTH						
HYDRO		- O/H CONNECTION								
TELEPH	ONE	- O/H CONNECTION								
GAS		-								
Informati	on Sheets:		-							
Commen	nts:	cs ^c	CURB STOP		———≥ WATER	SERVICE RY SERVICE			— GAS — GAS — E — ELECTE	RICAL

THE INFORMATION CONTAINED HEREIN IS FOR INTERNAL USE ONLY. NOT TO BE RELIED UPON UNLESS CONFIRMED BY THE SITE INSPECTION AND/OR INVESTIGATION

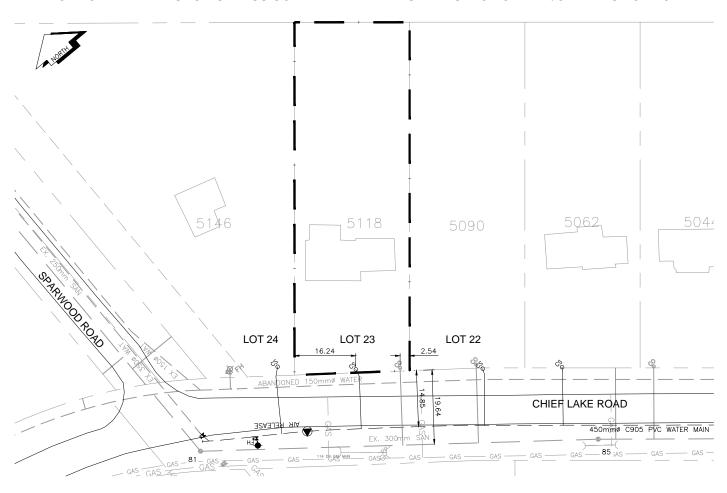

SANITARY, STORM & WATER SERVICE INVERTS	SANITARY	WATER	STORM
1. Distance from San. M.H. <u>85</u> toward San. M.H. <u>81</u> to lot service connection point is:	51.68m	62.55m	
2. Main Size at connection point is	100mmØ	19mmØ	
3. Obvert of main at conn. stub point is	757.79m	761.34m	
4. Obvert at service end is		761.61m	
5. Cover at property line in meters			
6. Survey Date: NOV 2014 Book Ref.:1035-55 By:L&M			
SANITARY HISTORY:			
DATE INSTALLED: -			
INSTALLED BY: -			
WATER HISTORY:			
DATE INSTALLED: SEPT 2014			
INSTALLED BY: CoPG			
MOTALLES ST. COST C			
STORM HISTORY:			
DATE INSTALLED: -			
INSTALLED BY: -			