

City of Prince George  
HISTORY SHEET

012596 62

SHEET NUMBER **5222** Roll Number

Legal: LOT'S **9 & 8** BLOCK **230** D.L. **343** PLAN **12-68**

Address: **675 PATRICIA BLVD.**

Sanitary Connection: # **1073** SIZE MATERIAL INV. **1888.62** CONNECTED

Water Connection # **2538** SIZE MATERIAL METER CONNECTED

Storm Connection: # SIZE MATERIAL INV. CONNECTED

Cash Receipt No's: WATER SANITARY STORM

CURB FROM PROPERTY LINE PAVEMENT WIDTH

B.C. HYDRO **O.H.** UNDERGROUND CONNECTION


B.C. TELEPHONE **O.H.** UNDERGROUND CONNECTION

INLAND GAS **AS SHOWN**

Information Sheets:

Comments:

SITE PLAN N.T.S.

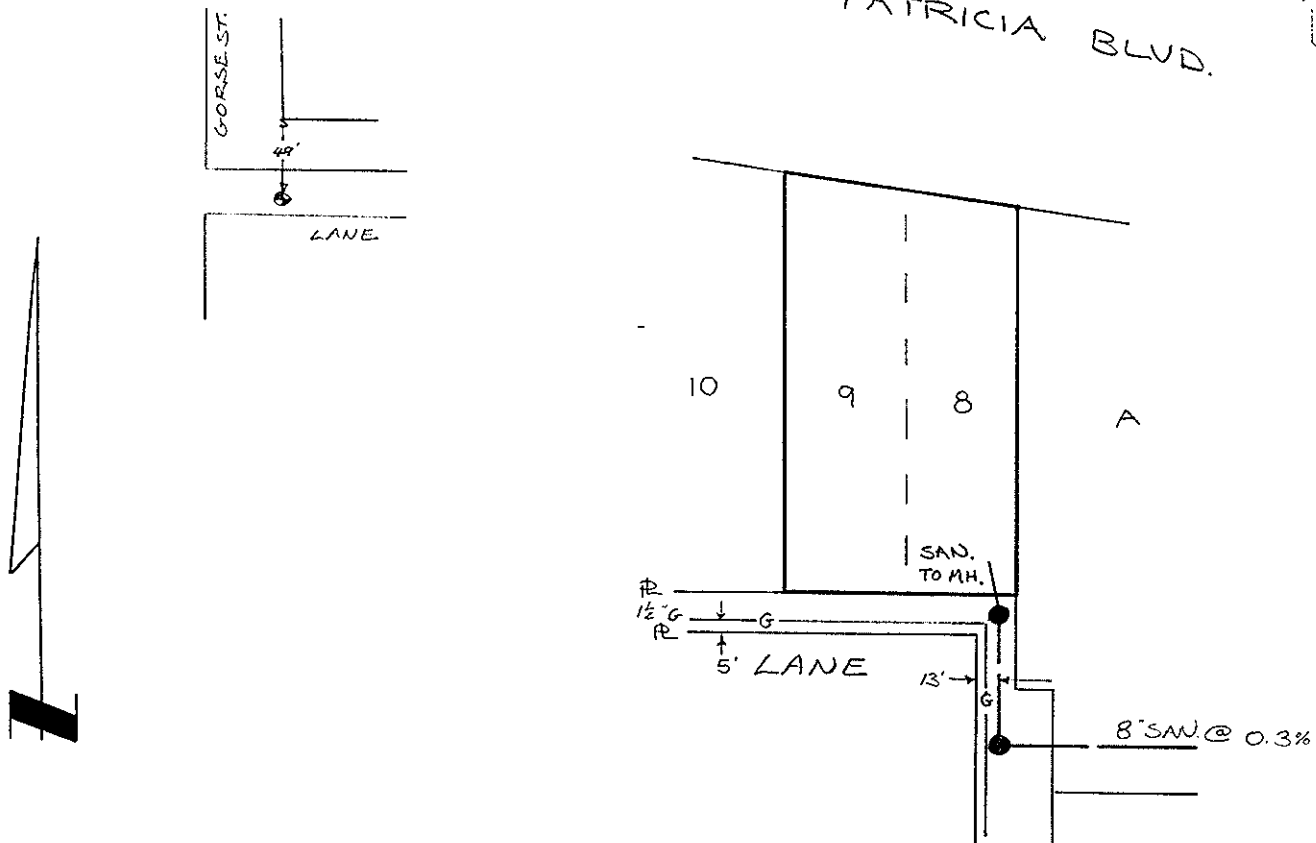

NOT  
CONN. JAN  
June 1/81