



City of Prince George

## History Sheet

PID:	012597520
	012597554
SD/MU:	
WO:	

Civic Address: 1492 Fir Street

Legal Description: Lot: 13 14 Block: 228 District Lot: 343 Plan: 1268


Service Type	Diameter (mm)	Material	Invert Elev at main (m)	Invert Elev at property line (m)	Invert Elev at service end (m)	Distance into property (m)	Installation Date
Sanitary	100mm	AC	-	-	-	-	January 1959
Water	20mm	Copper	-	-	-	-	January 1957
Storm	N/A	N/A	-	-	-	-	

Service Connection Location				Sanitary (m)	Storm (m)
Distance from downstream San MH	3996	towards upstream San MH	784	17.90	
Distance from downstream Stm MH	-	towards upstream Stm MH	-		

Power	Size	Communications	Size	Cable	Size	Gas	Size
BC Hydro	-	Telus	-	Shaw	-	FortisBC	-
Overhead Service		Overhead Service		Overhead Service			

Installed by:	City of Prince George forces	Survey Date:	-
Comments:			

**NOT TO SCALE** The information contained herein is for internal use only.  
**Not to be relied on unless confirmed by site inspection and/or investigation.**

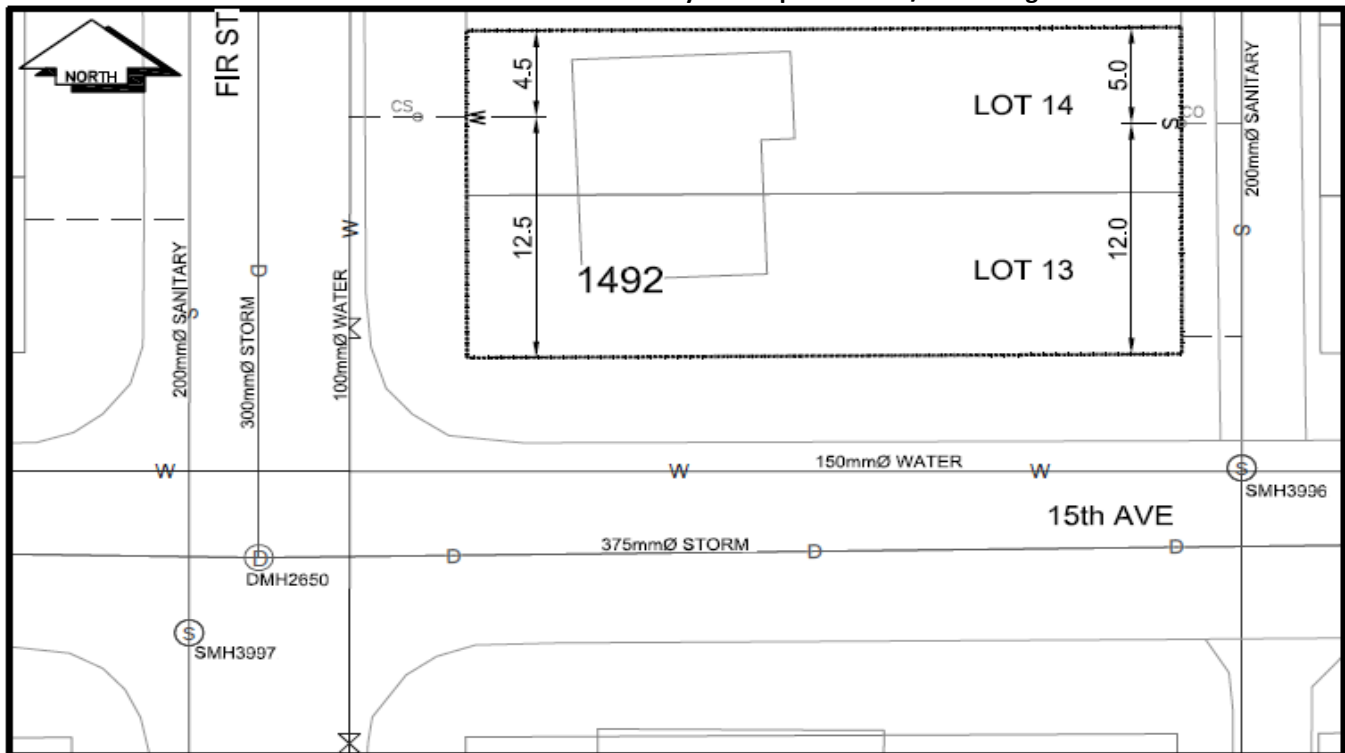

CS	CURB STOP	---	WATER SERVICE	---	STORM SERVICE
CO	CLEAN OUT	---	SANITARY SERVICE	---	GAS
⊗	WATER VALVE	⊗	FIRE HYDRANT	---	ENCUMBRANCE

**NOT TO SCALE**