

City of Prince George

HISTORY SHEET

PID: **012638986**

Scale: 1:1000

Legal: 21

D.L.: 2424

PLAN: 10807

Address: **5062 CHIEF LAKE ROAD**

Sanitary Connection: 16645 SIZE: 100mmØ MATERIAL: PVC INV. CONNECTED

Water Connection: SIZE: 19mmØ MATERIAL: COPPER INV. 760.24m CONNECTED

Storm Connection: SIZE MATERIAL INV.

Cash Receipt No's: WATER SANITARY STORM

CURB FROM PROPERTY LINE PAVEMENT WIDTH

HYDRO - O/H CONNECTION


TELEPHONE - O/H CONNECTION

GAS -

Information Sheets: -

Comments: CS^o CURB STOP CO^o CLEAN OUT —≧— WATER SERVICE —S— SANITARY SERVICE —GAS— GAS —E— ELECTRICAL

**THE INFORMATION CONTAINED HEREIN IS FOR INTERNAL USE ONLY.
NOT TO BE RELIED UPON UNLESS CONFIRMED BY THE SITE INSPECTION AND/OR INVESTIGATION**

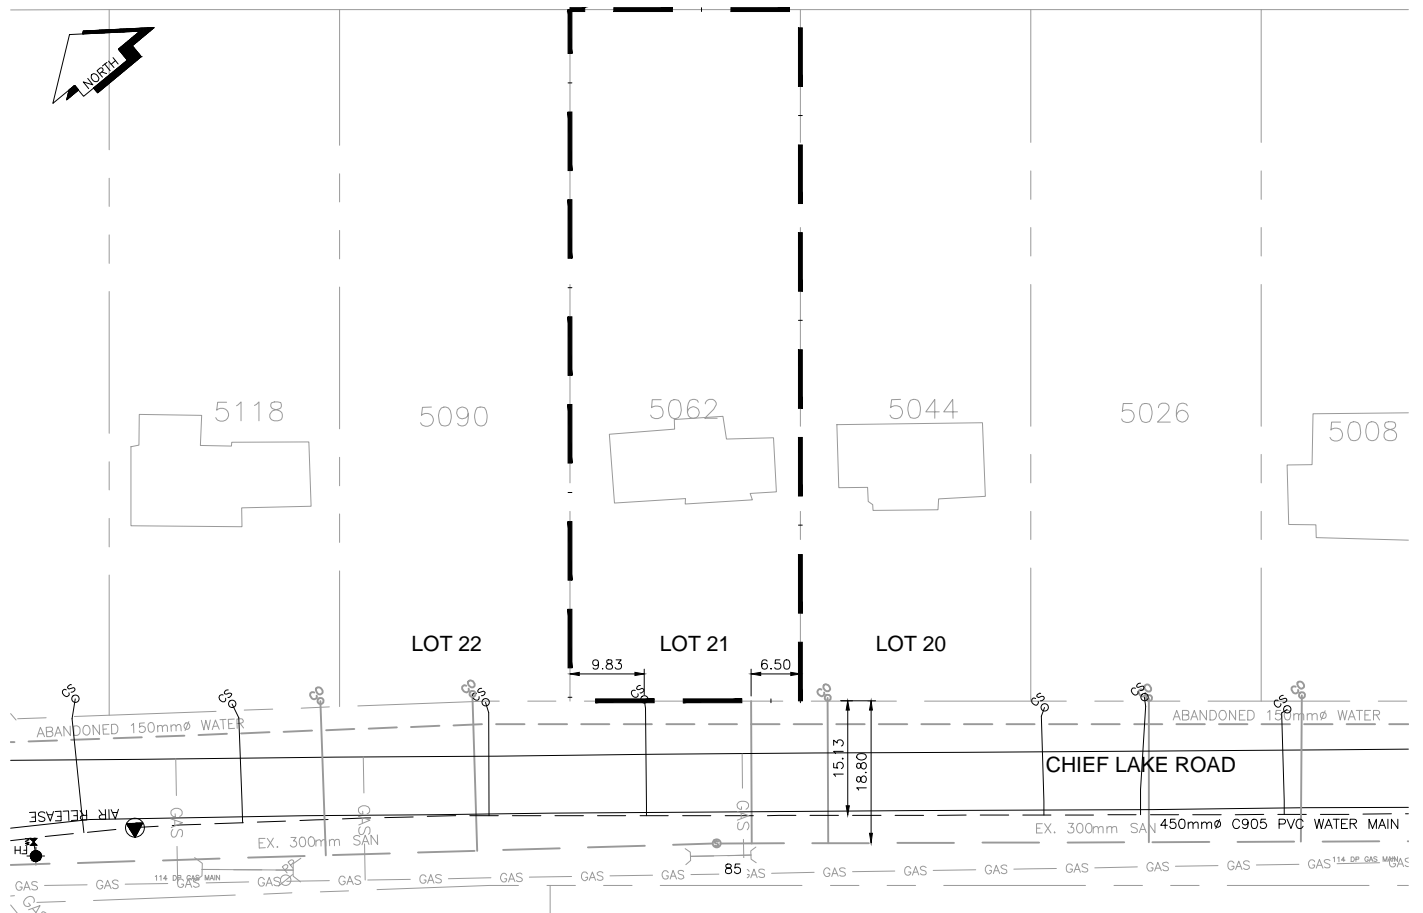

SANITARY, STORM & WATER SERVICE INVERTS	SANITARY	WATER	STORM
1. Distance from San. M.H. <u>86</u> toward San. M.H. <u>85</u> to lot service connection point is:	95.70m		
2. Main Size at connection point is	100mmØ	19mmØ	
3. Obvert of main at conn. stub point is	757.61m	761.52m	
4. Obvert at service end is		760.26m	
5. Cover at property line in meters			
6. Survey Date:NOV 2014 Book Ref.:1035-55 By:L&M			

SANITARY HISTORY:

DATE INSTALLED: -

INSTALLED BY: -

NO SANITARY CLEAN OUT LOCATED ON LOT 21

WATER HISTORY:

DATE INSTALLED: SEPT 2014

INSTALLED BY: CoPG

STORM HISTORY:

DATE INSTALLED: -

INSTALLED BY: -