



# City of Prince George History Sheet

PID:	012648728
	012648736
SD/MU:	
WO:	

Civic Address: 1616 11th Ave

Legal Description: Lot: 15, 16 Block: 203 District Lot: 343 Plan: 1268


Service Type	Diameter (mm)	Material	Invert Elev at main (m)	Invert Elev at property line (m)	Invert Elev at service end (m)	Distance into property (m)	Installation Date
Sanitary	100mm	AC	-	571.16	-	-	January 1959
Water	20mm	Copper	-	-	-	-	January 1959
Storm	N/A	N/A	-	-	-	-	

Service Connection Location				Sanitary (m)	Storm (m)
Distance from downstream San MH	752	towards upstream San MH	2853	33.59	
Distance from downstream Stm MH	-	towards upstream Stm MH	-		

Power	Size	Communications	Size	Cable	Size	Gas	Size
BC Hydro	-	Telus	-	Shaw	-	FortisBC	-
Overhead Service		Overhead Service		Overhead Service			

Installed by:		Survey Date:	-
Comments:	Water svce location confirmed May 5. 2017.		

**NOT TO SCALE** The information contained herein is for internal use only.  
Not to be relied on unless confirmed by site inspection and/or investigation.

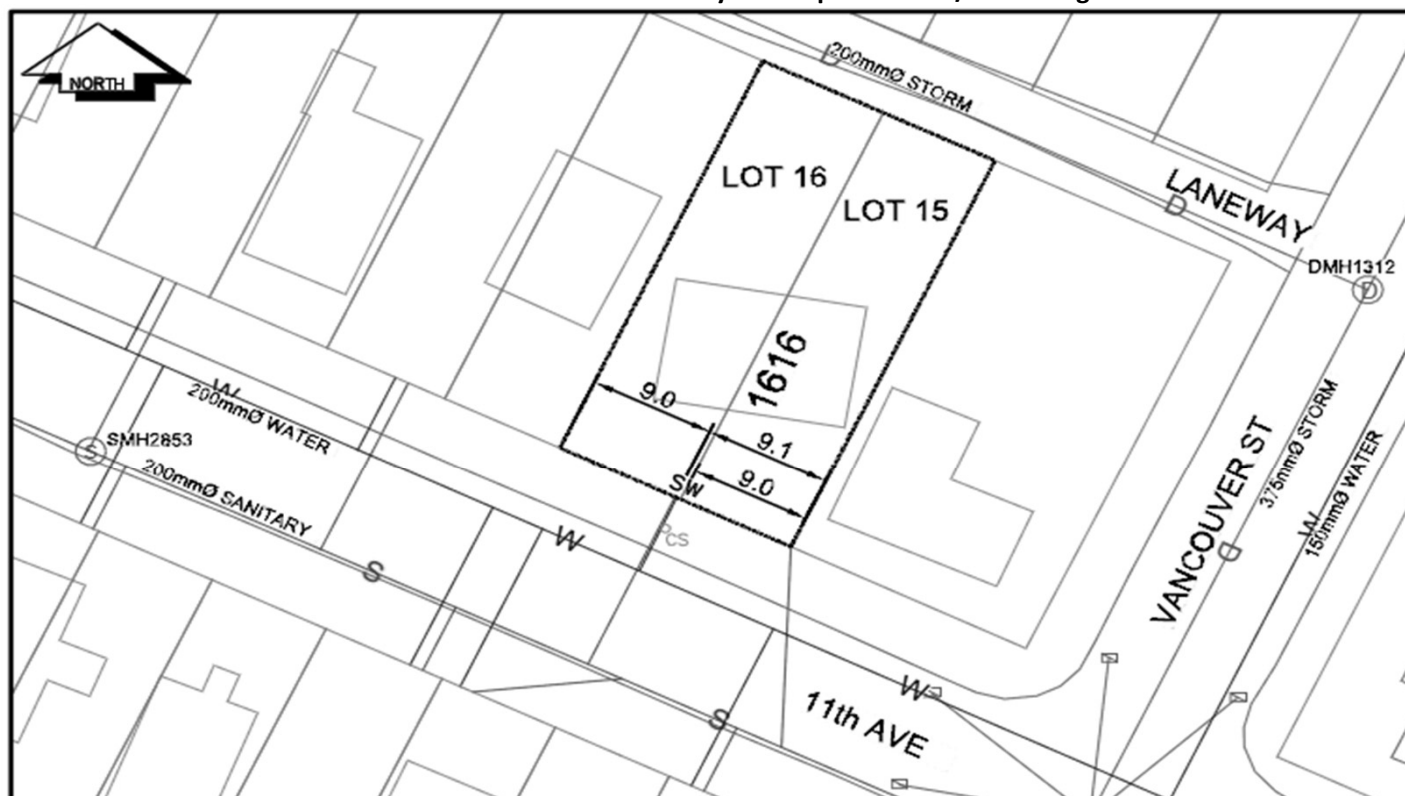

CS	CURB STOP	—	WATER SERVICE	—	STORM SERVICE
CO	CLEAN OUT	- - -	SANITARY SERVICE	— G —	GAS
WV	WATER VALVE	—	FIRE HYDRANT	- - -	ENCUMBRANCE

**NOT TO SCALE**