


City of Prince George

HISTORY SHEET

012670529		Scale: 1:1000	
PID: 012670539			
Legal: 17	D.L.: 2424	PLAN: 10807	
Address: 4980 CHIEF LAKE ROAD			
Sanitary Connection: 16649	SIZE: 100mmØ	MATERIAL: PVC	INV. 759.02m CONNECTED
Water Connection:	SIZE: 19mmØ	MATERIAL: COPPER	INV. 759.74m CONNECTED
Storm Connection:	SIZE	MATERIAL	INV.
Cash Receipt No's:	WATER	SANITARY	STORM
CURB FROM PROPERTY LINE		PAVEMENT WIDTH	
HYDRO	-	O/H CONNECTION	
TELEPHONE	-	O/H CONNECTION	
GAS	-		

Information Sheets:	-		
Comments:	CS ^o CURB STOP CO ^o CLEAN OUT	—≧ WATER SERVICE —S SANITARY SERVICE	— GAS — GAS — E — ELECTRICAL

**THE INFORMATION CONTAINED HEREIN IS FOR INTERNAL USE ONLY.
NOT TO BE RELIED UPON UNLESS CONFIRMED BY THE SITE INSPECTION AND/OR INVESTIGATION**

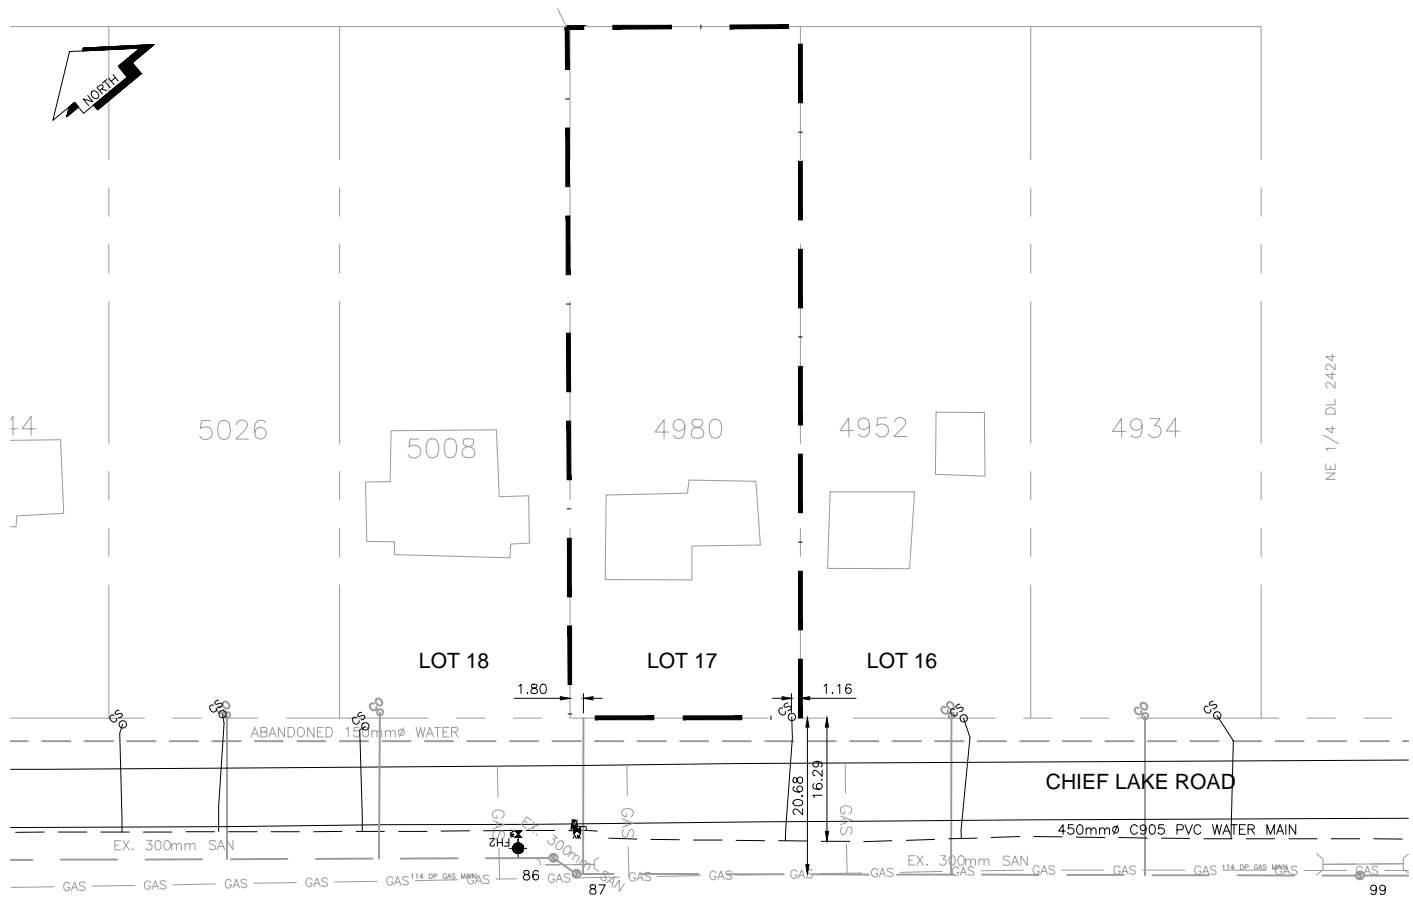

SANITARY, STORM & WATER SERVICE INVERTS	SANITARY	WATER	STORM
1. Distance from San. M.H. <u>99</u> toward San. M.H. <u>87</u> to lot service connection point is:	102.69m	75.96m	
2. Main Size at connection point is	100mmØ	19mmØ	
3. Obvert of main at conn. stub point is	757.21m	759.64m	
4. Obvert at service end is		759.76m	
5. Cover at property line in meters			
6. Survey Date:NOV 2014 Book Ref.:1035-55 By:L&M			

SANITARY HISTORY:

DATE INSTALLED: -

INSTALLED BY: -

NO SANITARY CLEAN OUT LOCATED ON LOT 17

WATER HISTORY:

DATE INSTALLED: SEPT 2014

INSTALLED BY: CoPG

STORM HISTORY:

DATE INSTALLED: -

INSTALLED BY: -