



City of Prince George History Sheet

PID:	012670677
SD/MU:	
WO:	

Civic Address: 2020 Ogilvie St

Legal Description: Lot: 85 District Lot: 936 Plan: 10868


Service Type	Diameter (mm)	Material	Invert Elev at main (m)	Invert Elev at property line (m)	Invert Elev at service end (m)	Distance into property (m)	Installation Date
Sanitary	100mm	AC	-	-	-	-	December 1975
Water	Unknown	Unknown	-	-	-	-	
Storm	400mm	Vit	-	-	-	-	December 1974

Service Connection Location	Sanitary (m)	Storm (m)
200mm Sanitary service connected to San MH3360	-	
400mm Storm service connected to Stm MH2669		

Power	Size	Communications	Size	Cable	Size	Gas	Size
BC Hydro	-	Telus	-	Shaw	-	FortisBC	-
Overhead Service		Overhead Service		Overhead Service			

Installed by:	Survey Date:	-
Comments:		

NOT TO SCALE The information contained herein is for internal use only.
Not to be relied on unless confirmed by site inspection and/or investigation.

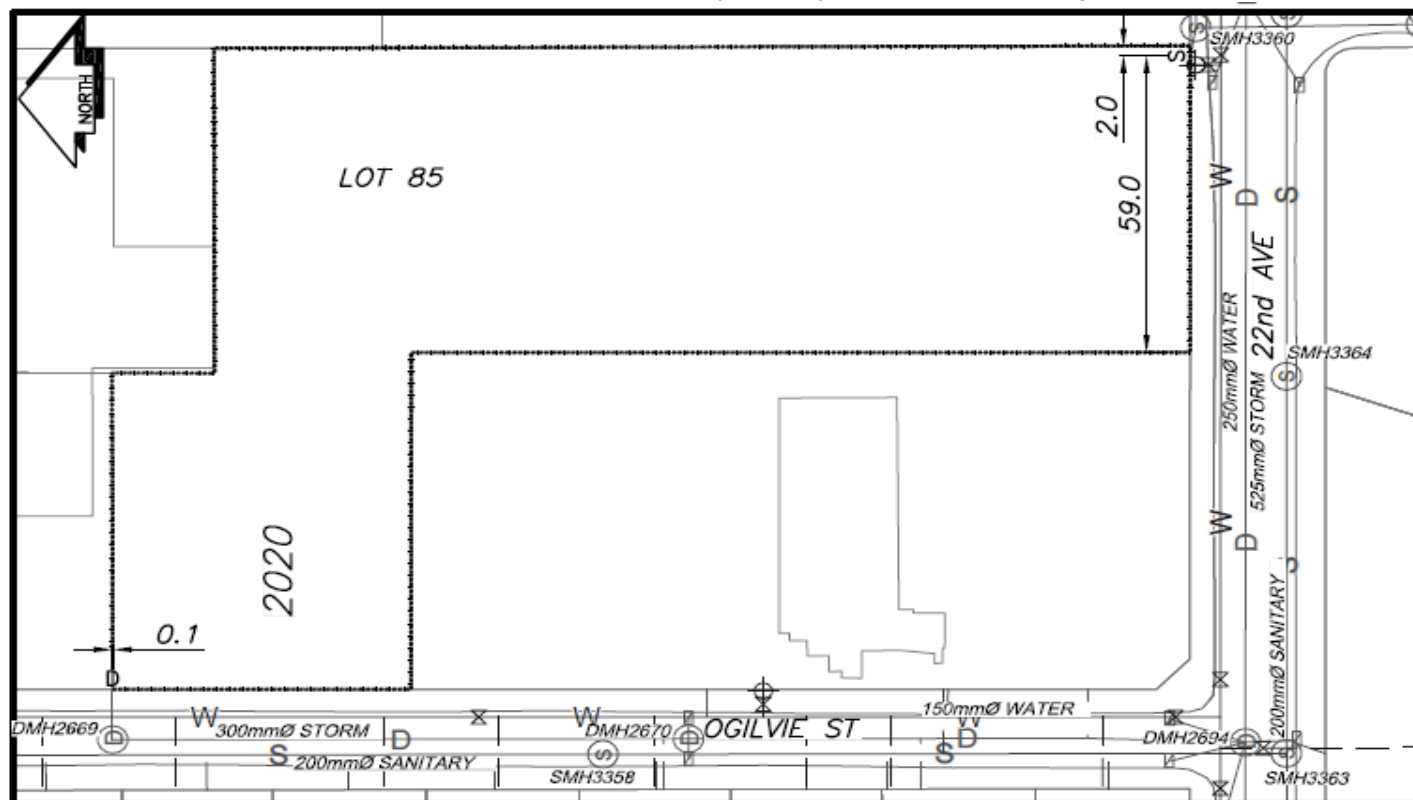

CS CURB STOP	—X— WATER SERVICE	—O— STORM SERVICE
CO CLEAN OUT	- - - - - SANITARY SERVICE	—G— GAS
X WATER VALVE	X—FIRE HYDRANT	- - - - - ENCUMBRANCE

NOT TO SCALE