



City of Prince George  
**History Sheet**

|        |           |
|--------|-----------|
| PID:   | 012759929 |
|        | 012759881 |
| SD/MU: |           |
| WO:    |           |

Civic Address: 1843 10th Ave

Legal Description: Lot: 6 (East 1/2), 7 Block: 205 District Lot: 343 Plan: 1268


| Service Type | Diameter (mm) | Material | Invert Elev at main (m) | Invert Elev at property line (m) | Invert Depth at service end (m) | Distance into property (m) | Installation Date |
|--------------|---------------|----------|-------------------------|----------------------------------|---------------------------------|----------------------------|-------------------|
| Sanitary     | 100mm         | AC       | -                       | 579.37                           | 2.42                            | -                          | December 1956     |
| Water        | 20mm          | Copper   | -                       | -                                | -                               | -                          | December 1956     |
| Storm        | N/A           | N/A      | -                       | -                                | -                               | -                          |                   |

| Service Connection Location     |      |                         |      | Sanitary (m) | Storm (m) |
|---------------------------------|------|-------------------------|------|--------------|-----------|
| Distance from downstream San MH | 2846 | towards upstream San MH | 3093 | 56.65        |           |
| Distance from downstream Stm MH | -    | towards upstream Stm MH | -    |              |           |

| Power            | Size | Communications   | Size | Cable            | Size | Gas      | Size |
|------------------|------|------------------|------|------------------|------|----------|------|
| BC Hydro         | -    | Telus            | -    | Shaw             | -    | FortisBC | -    |
| Overhead Service |      | Overhead Service |      | Overhead Service |      |          |      |

|               |              |   |
|---------------|--------------|---|
| Installed by: | Survey Date: | - |
| Comments:     |              |   |
|               |              |   |
|               |              |   |

**NOT TO SCALE** The information contained herein is for internal use only.  
Not to be relied on unless confirmed by site inspection and/or investigation.

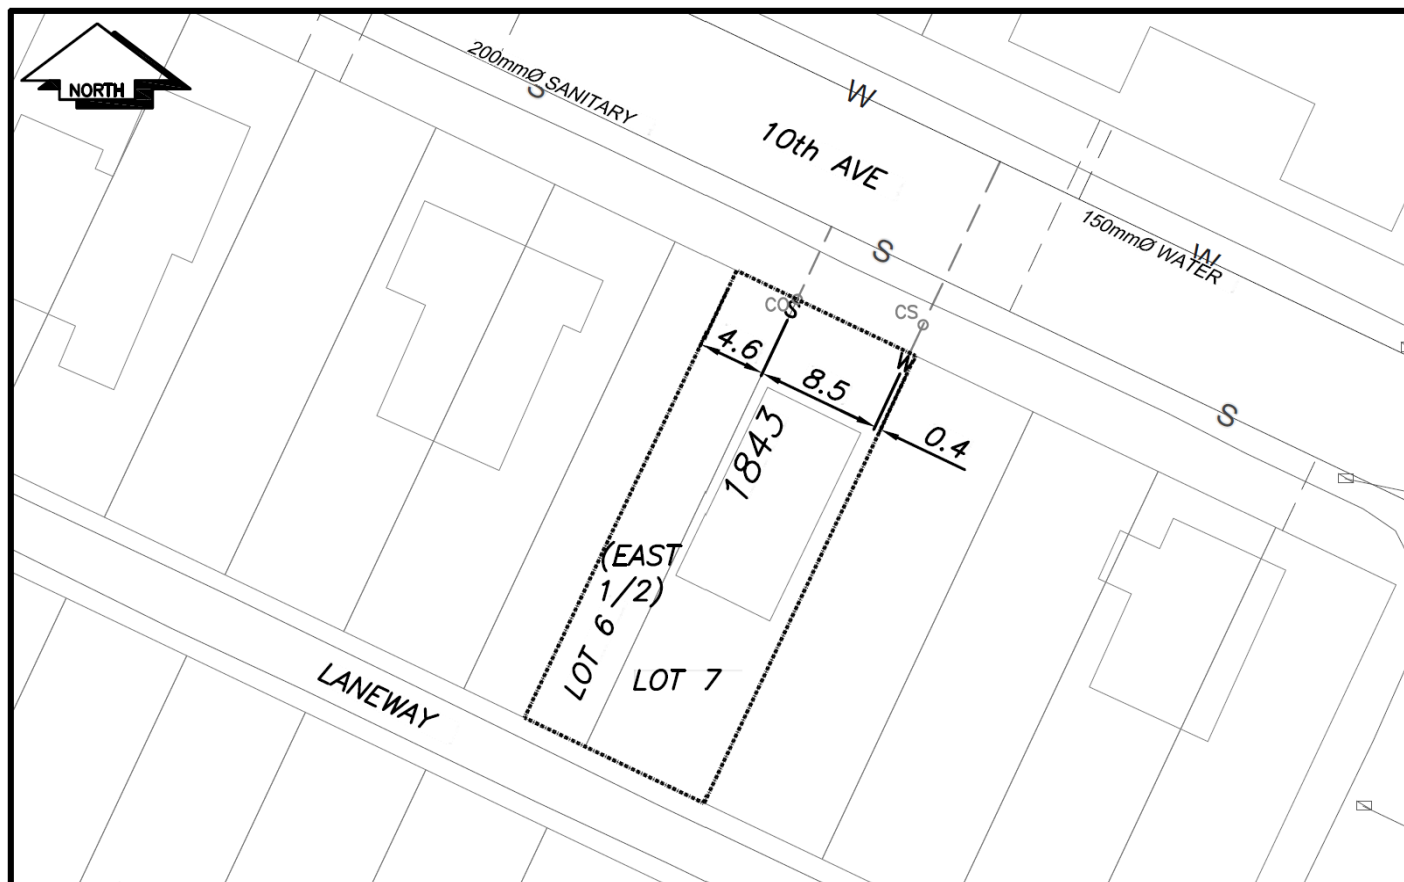

|    |             |     |                  |     |               |
|----|-------------|-----|------------------|-----|---------------|
| CS | CURB STOP   | W   | WATER SERVICE    | CS  | STORM SERVICE |
| CO | CLEAN OUT   | --- | SANITARY SERVICE | G   | GAS           |
| WV | WATER VALVE | ⊗   | FIRE HYDRANT     | --- | ENCUMBRANCE   |