



City of Prince George
History Sheet

PID:	012759929
	012759881
SD/MU:	
WO:	

Civic Address: 1843 10th Ave

Legal Description: ~~Lot: 6 (East 1/2), 7 Block: 205 District Lot: 343 Plan: 1268~~ **Lot A District Lot 343 Plan EPP111528**


Service Type	Diameter (mm)	Material	Invert Elev at main (m)	Invert Elev at property line (m)	Invert Depth at service end (m)	Distance into property (m)	Installation Date
Sanitary	100mm	AC	-	579.37	2.42	-	December 1956
Water	20mm	Copper	-	-	-	-	December 1956
Storm	N/A	N/A	-	-	-	-	

Service Connection Location				Sanitary (m)	Storm (m)
Distance from downstream San MH	2846	towards upstream San MH	3093	56.65	
Distance from downstream Stm MH	-	towards upstream Stm MH	-		

Power	Size	Communications	Size	Cable	Size	Gas	Size
BC Hydro	-	Telus	-	Shaw	-	FortisBC	-
Overhead Service		Overhead Service		Overhead Service			

Installed by:	Survey Date:	-
Comments:		

NOT TO SCALE The information contained herein is for internal use only.
Not to be relied on unless confirmed by site inspection and/or investigation.

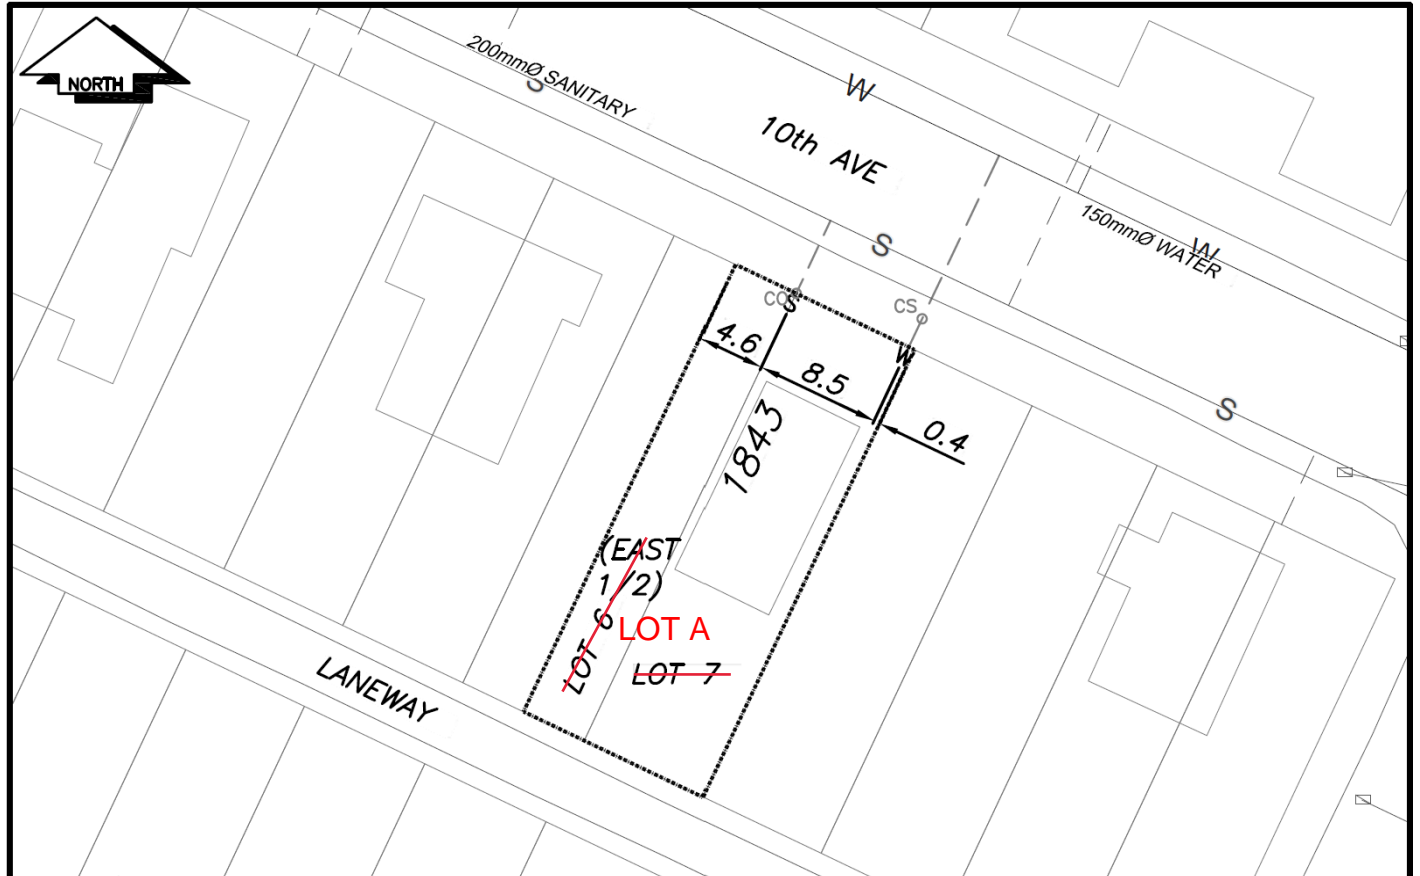

LEGEND:	 CURB STOP		 STORM SERVICE
	 CLEAN OUT	 SANITARY SERVICE	 GAS
	 WATER VALVE	 FIRE HYDRANT	 ENCUMBRANCE

LEGEND: