
## City of Prince George HISTORY SHEET

01246+451

SHEET NUMBER		Roll Number			
Legal: LOT'S 3	BLOCK N	D.L.	936	plan 10005	
Address: 1980	Finlay Dr.				
Sanitary Connection: # 40	\\\\\\\\\\\\\\\\\\\\\\\\\\\\\\\\\\\\\\	MATERIAL	INV.	CONNECTED	
Water Connection # 38	SIZE ZOMY	MATERIAL CU	. METER	CONNECTED	
Storm Connection: #	SIZE	MATERIAL	INV.	CONNECTED	
Cash Receipt No's:	VATER	SANITARY		STORM	
CURB FROM PROPERTY LINE 5	<b>D</b> .		PAVEMENT V	VIDTH	
B.C. HYDRO		UNDERGROUND CONNECTION			
B.C. TELEPHONE		UNDERGROUND CONNECTION			
INLAND GAS					
Information Sheets:					
Comments:					
·					



3

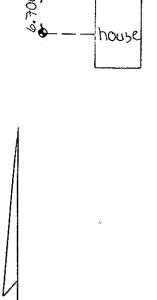