

LEGEND:

WATER VALVE

## City of Prince George **History Sheet**

012778320	PID:
	SD/MU:
	WO:

ENCUMBERANCE

Civic Address: 1662 9th Ave

Legal Description: Lot: 20 Block: 190 District Lot: 343 Plan: 1268


Service Type	Diameter (mm)	Material	Invert Elev at main (m)	Invert Elev at property line (m)	Invert Depth at service end (m)	Distance into property (m)	Installation Date
Sanitary	100mm	AC	-	575.08	1.74	-	December 1956
Water	20mm	Copper	-	-	=	-	December 1956
Storm	N/A	N/A	-	-	-	-	

Service Connection Location				Sanitary (m)	Storm (m)
Distance from downstream San MH	2857	towards upstream San MH	3094	75.77	
Distance from downstream Stm MH	-	towards upstream Stm MH	-		

Power	Size	Communications	Size	Cable	Size	Gas	Size
BC Hydro	-	Telus	-	Shaw	-	FortisBC	-
Overhead	Overhead Service Overhead Service		Overhead	Overhead Service		·	

Installed by:	Survey Date:	-
Comments:		

NOT TO SCALE The information contained herein is for internal use only. Not to be relied on unless confirmed by site inspection and/or investigation.

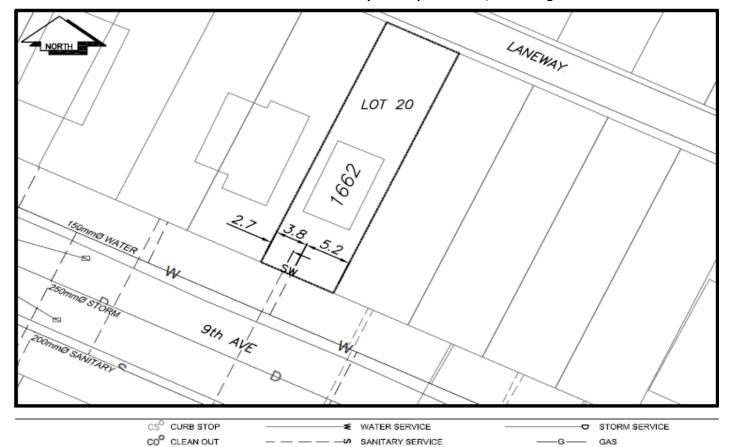

FIRE HYDRANT