

City of Prince George HISTORY SHEET

512104098

SHEET NUMBER _____ Roll Number _____

Legal: LOT'S 15 BLOCK M D.L. 936 PLAN 10,005

Address: 1920 Findlay Dr.

Sanitary Connection: # 4013 SIZE _____ MATERIAL _____ INV. _____ CONNECTED _____

Water Connection # 3813 SIZE 20mm MATERIAL Cu METER _____ CONNECTED _____

Storm Connection: # _____ SIZE _____ MATERIAL _____ INV. _____ CONNECTED _____

Cash Receipt No's: WATER _____ SANITARY _____ STORM _____

CURB FROM PROPERTY LINE 5m PAVEMENT WIDTH _____


B.C. HYDRO _____ UNDERGROUND CONNECTION _____

B.C. TELEPHONE _____ UNDERGROUND CONNECTION _____

INLAND GAS ☒ _____

Information Sheets: _____

Comments: _____

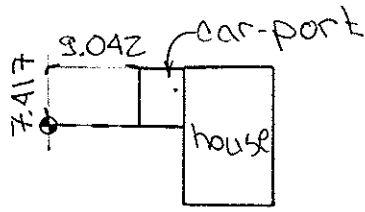

SITE

PLAN

N.T.S.

