

## City of Prince George HISTORY SHEET

312787 474

SHEET NUMBER								PID	#
Legal: Lot's	10		BLOCK		<del></del>		D.L.	936	PLAN 10 005
Address:	25	45 E	WE	RT	C	RES	SEN	7	
Sanitary Connection:	#	3841	SIZE	100	mm	MATERIAL	A.C.	INV.	CONNECTED
Water Connection:	#	3720	SIZE	20	mm	MATERIAL	دن.	METER	CONNECTED
Storm Connection:	#		SIZE		mm	MATERIAL		INV.	CONNECTED
Cash Receipt No's:		WATER			SA	NITARY			STORM
CURB FROM PROPERTY LINE	4.	877 m						PAVEM	ENT WIDTH 10.363 M
B.C. HYDRO	14					UNDERGRO	UND CONNEC	CTION	
B.C. TELEPHONE	1/4	<u>!</u>				UNDERGRO	UND CONNEC	CTION	
INLAND GAS Å	5	SHOWN	دا د	LA	NE	***************************************			
Information Sheets:									
Comments:									

## THE INFORMATION CONTAINED HEREIN IS FOR INTERNAL USE ONLY. NOT TO BE RELIED UPON UNLESS CONFIRMED BY SITE INSPECTION AND/OR INVESTIGATION

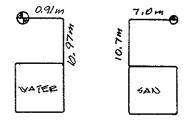

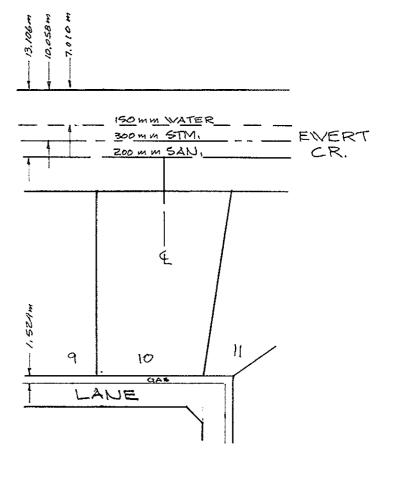

REPORT TO RECORDS

**SEWER SERVICE INFORMATION** 

Lot No.	Block	D.L
Address <u>3545</u>	EWERT CR.	
Size of Connection	∰ 100mm □ 150mm	☐ 200mm ☐ Other
Type of Connection	☐ Transite ☑ PVC	☐ Other
Type of Cap	☐ Transite ☐ Cast Iro	n 🛦
LOCATION SKETCH		
<del></del>	EWERT CR	
SEWER	2545	3.3 <sup>M</sup> 7
Field Location By Checked by Foreman	Josefforti	Date <u>Oct</u> . <b>1</b> /95