


# City of Prince George Lot History Sheet

PID	Civic Address	Lot	Block	Plan	DL	Free Legal
012786594	3175 19TH AVE	15	I	10005	936	

Size (mm)	Material	Invert @ PL	Cut @ PL	Survey Date	Field Book	Location	Comments
Sanitary			2.26m				CONN# 4183
Water	20" CU						CONN# 3983
Storm							

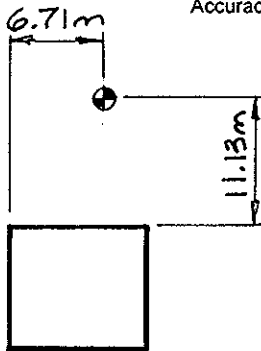

Accuracy Not Guaranteed Unless Confirmed By Site Inspection and/or Investigation.  
Sketch is Oriented North (NTS)

