



# City of Prince George History Sheet

PID:	012803537
MU:	102156
WO:	100466/100465

Civic Address: 1642 9th Ave

Legal Description: Lot: 16 Block: 190 District Lot: 343 Plan: 1268


Service Type	Diameter (mm)	Material	Invert Elev at main (m)	Invert Elev at property line (m)	Invert Elev at service end (m)	Distance into property (m)	Installation Date
Sanitary	100mm	PVC	575.67	575.07	-	-	August 2019
Water	20mm	Copper	0.00	575.09	-	-	August 2019
Storm	N/A	N/A	-	-	-	-	

Service Connection Location				Sanitary (m)	Storm (m)
Distance from downstream San MH	2857	towards upstream San MH	3094	37.89	
Distance from downstream Stm MH	-	towards upstream Stm MH	-		

Power	Size	Communications	Size	Cable	Size	Gas	Size
BC Hydro	-	Telus	-	Shaw	-	FortisBC	-
Overhead Service		Overhead Service		Overhead Service			

Installed by:	City of Prince George forces	Survey Date:	-
Comments:			

**NOT TO SCALE** The information contained herein is for internal use only.  
Not to be relied on unless confirmed by site inspection and/or investigation.

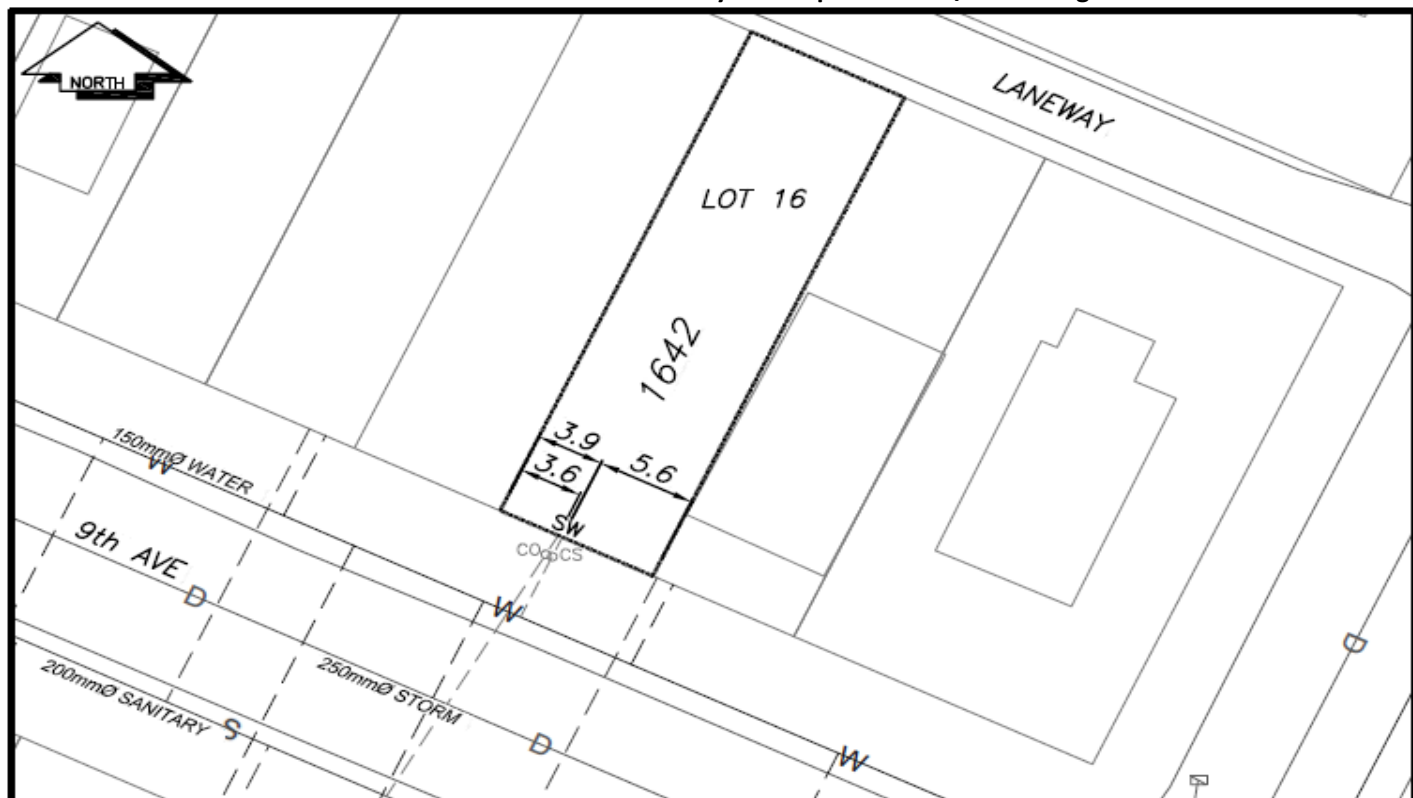

CS <sup>o</sup> CURB STOP	—W— WATER SERVICE	—S— STORM SERVICE
CO <sup>o</sup> CLEAN OUT	- - - - - SANITARY SERVICE	—G— GAS
⊗ WATER VALVE	⊗ FIRE HYDRANT	- - - - - ENCUMBRANCE

**NOT TO SCALE**