



City of Prince George History Sheet

PID:	012817333
SD/MU:	
WO:	

Civic Address: 1751 Gorse St

Legal Description: Lot: 8 Block: 292 District Lot: 343 Plan: 1268


Service Type	Diameter (mm)	Material	Invert Elev at main (m)	Invert Elev at property line (m)	Invert Elev at service end (m)	Distance into property (m)	Installation Date
Sanitary	100mm	AC	-	573.72	2.86	-	December 1955
Water	20mm	Copper	-	-	-	-	December 1955
Storm	N/A	N/A	-	-	-	-	

Service Connection Location				Sanitary (m)	Storm (m)
Distance from downstream San MH	3211	towards upstream San MH	3210	35.82	
Distance from downstream Stm MH	-	towards upstream Stm MH	-		

Power	Size	Communications	Size	Cable	Size	Gas	Size
BC Hydro	-	Telus	-	Shaw	-	FortisBC	-
Overhead Service		Overhead Service		Overhead Service			

Installed by:		Survey Date:	-
Comments:	Water service location confirmed August 2017		

NOT TO SCALE The information contained herein is for internal use only.
Not to be relied on unless confirmed by site inspection and/or investigation.

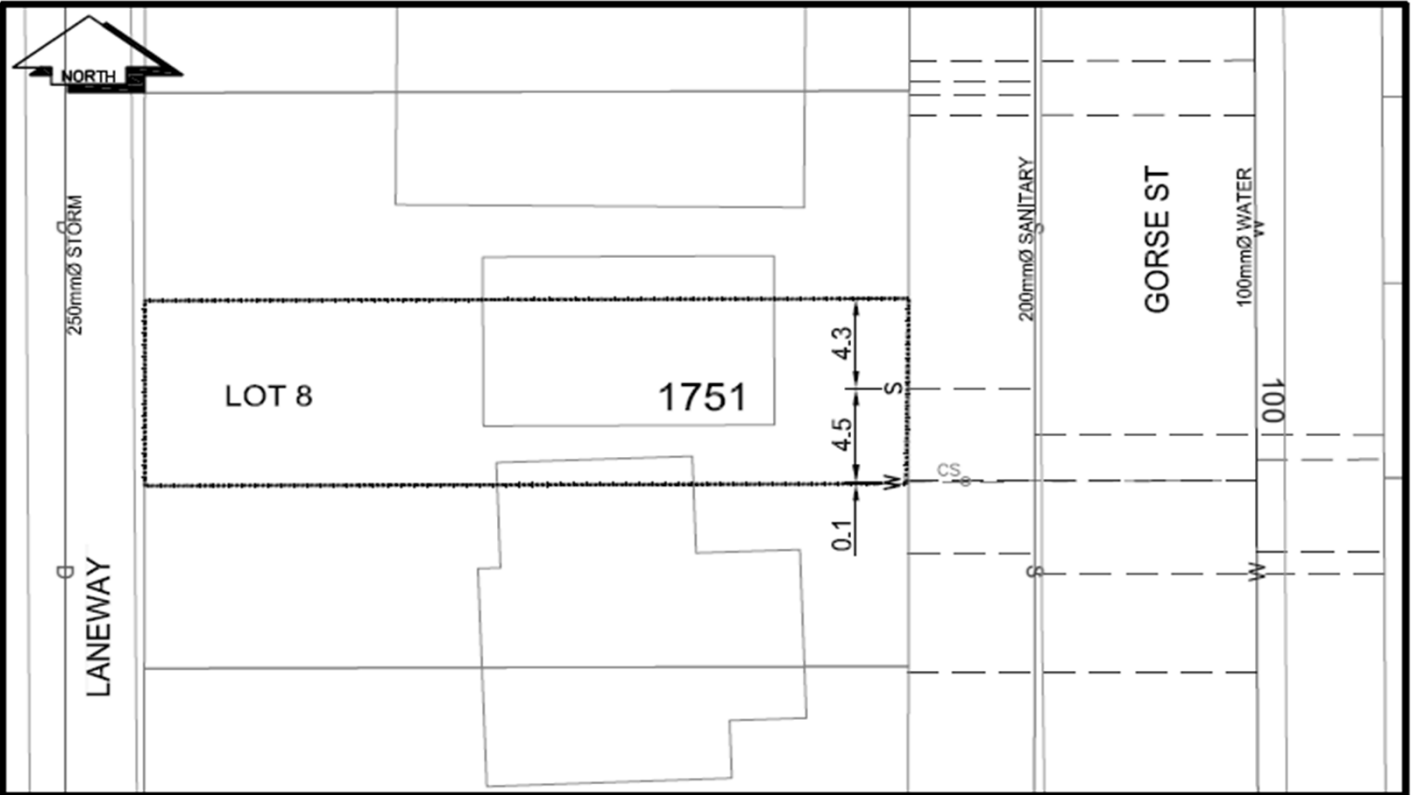

CS ^o CURB STOP	--- W --- WATER SERVICE	--- S --- STORM SERVICE
CO ^o CLEAN OUT	--- S --- SANITARY SERVICE	--- G --- GAS
⊗ WATER VALVE	⊗ FIRE HYDRANT	--- ENCUMBRANCE

NOT TO SCALE