

**City of Prince George
HISTORY SHEET**

5128273005

SHEET NUMBER **Nº 1580** Roll Number **1**

Legal: LOT'S **8** BLOCK **B** D.L. **936** PLAN **10005**

Address: **1645 - HARPER DR.**

Sanitary Connection: # **4114** SIZE MATERIAL INV. CONNECTED

Water Connection # **3914** SIZE **3/4"** MATERIAL **CU** METER CONNECTED

Storm Connection: # SIZE MATERIAL INV. CONNECTED

Cash Receipt No's: WATER SANITARY STORM

CURB FROM PROPERTY LINE PAVEMENT WIDTH


B.C. HYDRO UNDERGROUND CONNECTION

B.C. TELEPHONE UNDERGROUND CONNECTION

INLAND GAS

Information Sheets:

Comments:

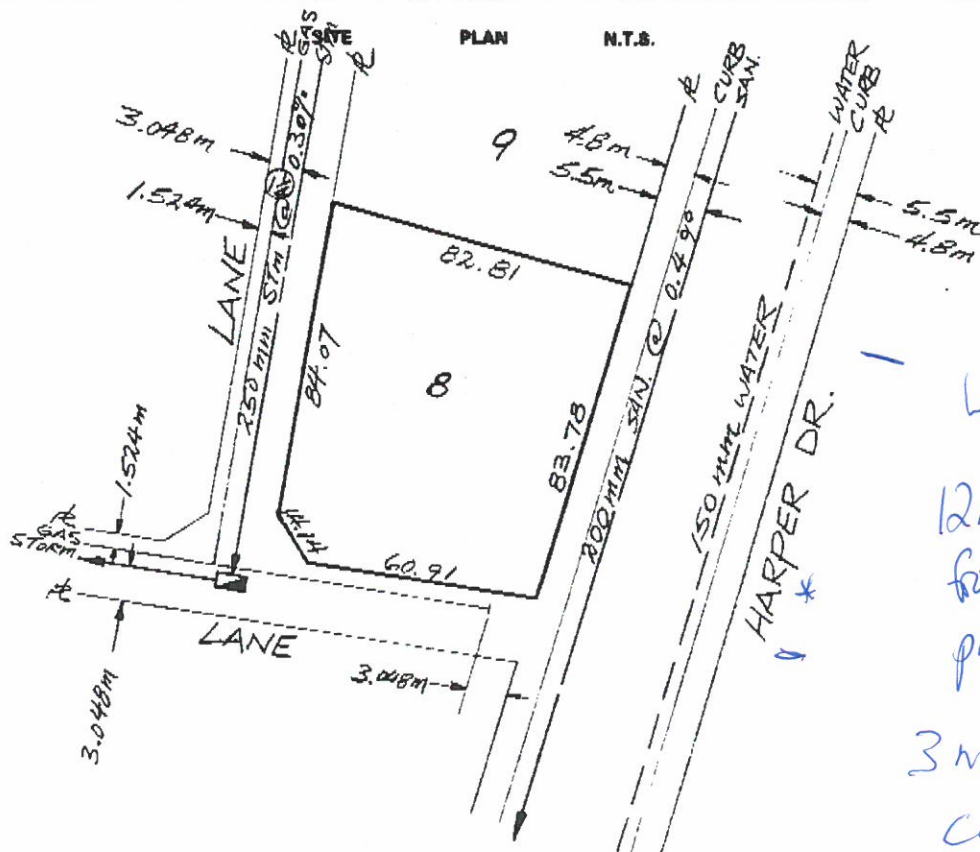

Water shut off
12m 6"
from North E.
property line
3m 7" from
curb