
City of Prince George HISTORY SHEET

012828246

SHEET NUMBER						PID #					
Legal: LOTS	٤	3	BLOCK		F		D.L.	936	PLAN	10 005	
Address:		2605	EV	VEF	<t< td=""><td>CRE</td><td>SEN</td><td>7</td><td></td><td></td></t<>	CRE	SEN	7			
Sanitary Connection:	#	3839	SIZE	100	mm	MATERIAL	A.C.	INV.		CONNECTED	
Water Connection:	#	3718	SIZE	20	mm	MATERIAL	CU.	METER		CONNECTED	
Storm Connection:	#		SIZE		mm	MATERIAL		INV.		CONNECTED	
Cash Receipt No's: WATER				SANITARY				STORM			
CURB FROM PROPERTY LINE		4.877 m	.					PAVEME	NT WIDTH	10.363 m	
B.C. HYDRO U/G				UNDERGROUND CONNECTION							
.C. TELEPHONE			٠	UNDERGROUND C				CONNECTION			
INLAND GAS A	6	SHOWN	117	LA	NE	•				,	
Information Sheets:											
Comments:											

THE INFORMATION CONTAINED HEREIN IS FOR INTERNAL USE ONLY. NOT TO BE RELIED UPON UNLESS CONFIRMED BY SITE INSPECTION AND/OR INVESTIGATION

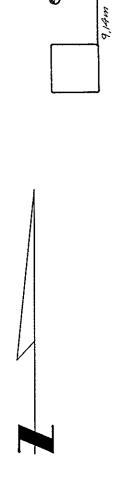

5,18m

