



City of Prince George
History Sheet

PID:	012837784
MU:	-
WO:	-

Civic Address: 1690 8th Ave

Legal Description: Lot: 24 Block: 180 District Lot: 343 Plan: 1268


Service Type	Diameter (mm)	Material	Invert Elev at main (m)	Invert Elev at property line (m)	Invert Elev at service end (m)	Distance into property (m)	Installation Date
Sanitary	100mm	AC	-	-	-	1.60	December 1985
Water	20mm	Copper	-	-	-	-	December 1956
Storm	N/A	N/A	-	-	-	-	

Service Connection Location				Sanitary (m)	Storm (m)
Distance from downstream San MH	3100	towards upstream San MH	3097	98.15	
Distance from downstream Stm MH	-	towards upstream Stm MH	-		

Power	Size	Communications	Size	Cable	Size	Gas	Size
BC Hydro	-	Telus	-	Shaw	-	FortisBC	-
Overhead Service		Overhead Service		Overhead Service			

Installed by:	Survey Date:	-
Comments:		

NOT TO SCALE The information contained herein is for internal use only.
Not to be relied on unless confirmed by site inspection and/or investigation.

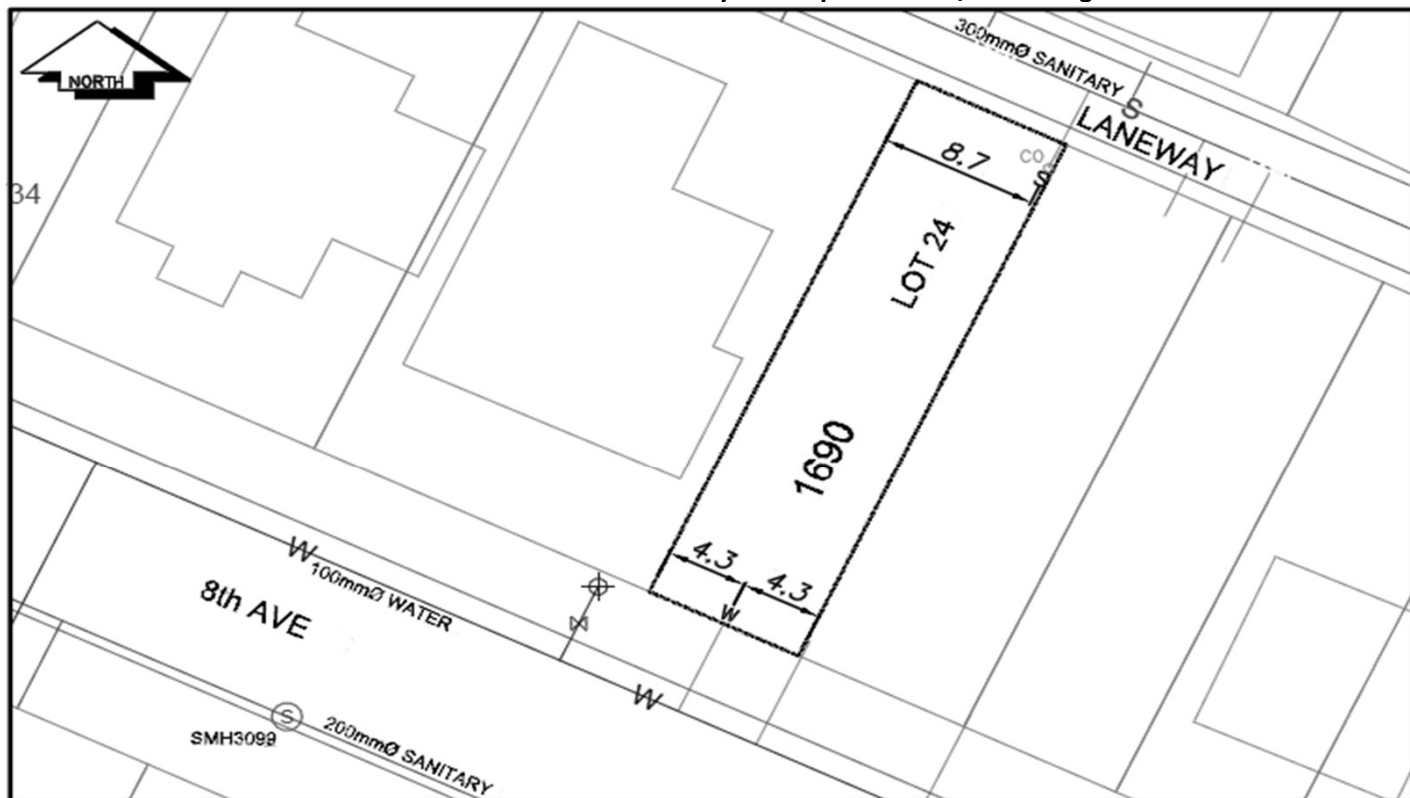

CS ^o CURB STOP	—≡— WATER SERVICE	—o— STORM SERVICE
CO ^o CLEAN OUT	- - - - - S SANITARY SERVICE	—G— GAS
⊗ WATER VALVE	⊗ FIRE HYDRANT	- - - - - ENCUMBRANCE

NOT TO SCALE