



City of Prince George History Sheet

PID:	012875279
SD/MU:	
WO:	

Civic Address: 1208, 1200 Cuddie Cres

Legal Description: Lot: 18 Block: B District Lot: 931 Plan: 7544


Service Type	Diameter (mm)	Material	Invert Elev at main (m)	Invert Elev at property line (m)	Invert epth at service end (m)	Distance into property (m)	Installation Date
Sanitary	100mm	AC	-	576.81	2.03	-	January 1967
Water	20mm	Copper	-	-	-	-	January 1957
Storm	N/A	N/A	-	-	-	-	

Service Connection Location				Sanitary (m)	Storm (m)
Distance from downstream San MH	3403	towards upstream San MH	3398	206.60	
Distance from downstream Stm MH	-	towards upstream Stm MH	-		

Power	Size	Communications	Size	Cable	Size	Gas	Size
BC Hydro	-	Telus	-	Shaw	-	FortisBC	-
Overhead Service		Overhead Service		Overhead Service			

Installed by:	Survey Date:	-
Comments:	Water service location confirmed April 28, 2017	

NOT TO SCALE The information contained herein is for internal use only.
Not to be relied on unless confirmed by site inspection and/or investigation.

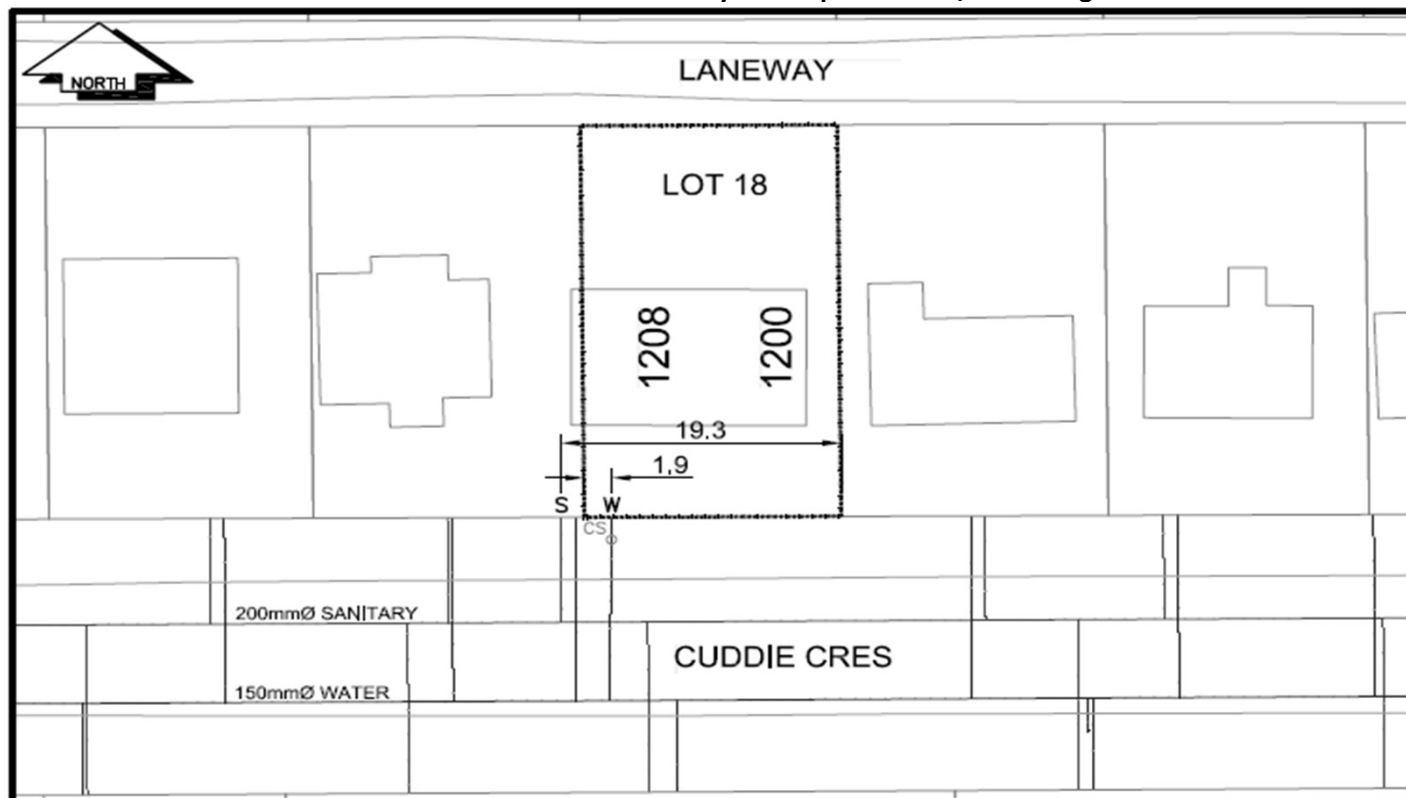

CS ^o CURB STOP	--- -- -- -- -- WATER SERVICE	--- -- -- -- -- STORM SERVICE
CO ^o CLEAN OUT	--- -- -- -- -- SANITARY SERVICE	--- -- -- -- -- GAS
⊗ WATER VALVE	⊗ FIRE HYDRANT	--- -- -- -- -- ENCUMBRANCE

NOT TO SCALE